


GRAYMARK OFFICE BUILDING

16801 Addison Road, Addison, Texas

SUITE 300
2,745 RSF

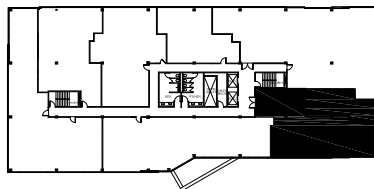

1ST FLOOR

Scale: 3/32"=1'-0"

All dimensions and square footages are approximate.

May 22, 2024



THOMPSON CONSULTING SERVICES, INC.

12024 Golden Meadow Lane, Forney, Texas 75126 (972)564-5252