

59,441 RSF +/- As Built Marketing Package

**3201 Pioneer Parkway
Suite 44
Arlington, Texas 76010**

**Sheet A28
Of 34 Sheet(s)**

**Scale: Not to Scale
Sheet Size: 11" x 8.5"
Not For Construction**




© 2025 HosScans, LLC.
All right reserved.
These drawings and any associated documents are protected under U.S. copyright law. No part of this work may be produced, distributed, or used in any form, by any method, for any purpose, without the prior written consent of HosScans, LLC. Unauthorized use is subject to legal action.

Usable Square Foot Analysis

OFFICE AREA:	1,440	89%
WAREHOUSE AREA:	170	11%
TOTAL AREA:	1,610	

Building Information

Deck Height:	12'0"
Clear Height:	10'0"
Ceiling Height:	8'
Sprinklered:	No
Mechanical Area:	N/A

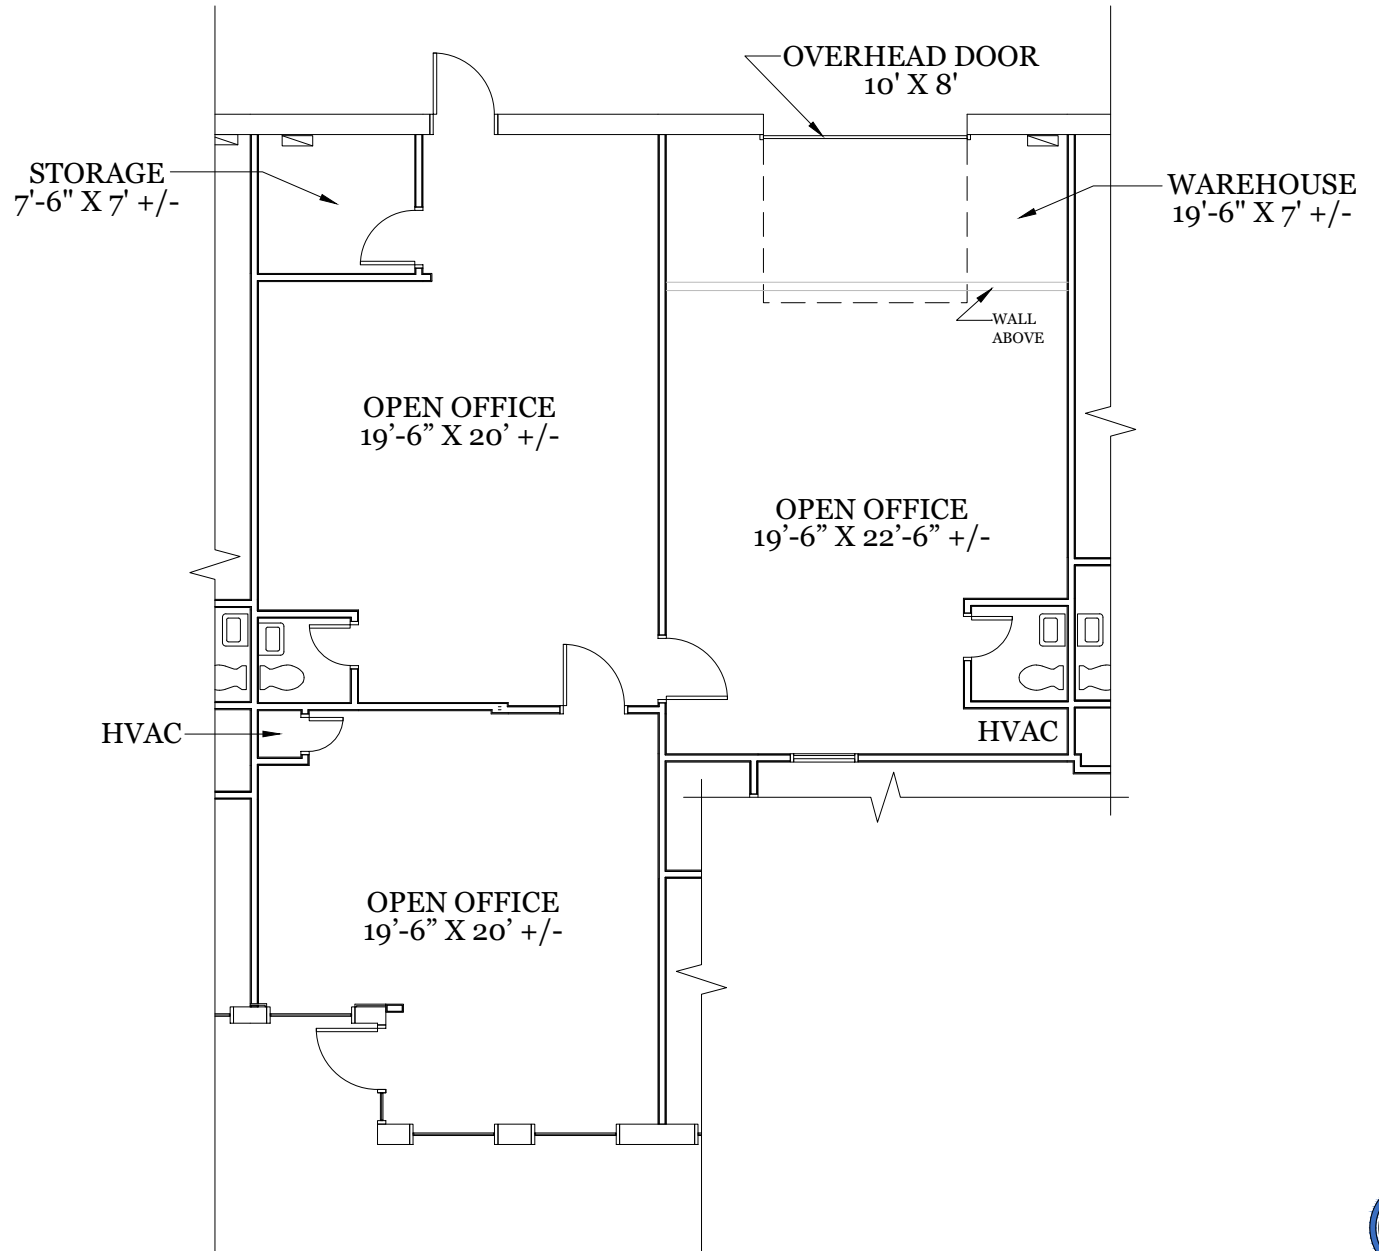

As Built Floor Plan for Marketing

