


**Austin Water  
Industrial Waste Plan Review**


has not observed the owner/operator  
violate from meeting the requirements  
1 of the Austin City Code (Code),  
of said establishment shall be  
making any necessary changes,  
alterations as required by the City  
in that all discharges to the sanitary  
in the Code.

DATE: 2-7-19  
BY: [Signature]  
TITLE: [Signature]  
[Signature]


IN ACCORDANCE WITH CITY OF AUSTIN PLUMBING CODES  
DATE: 2-7-19  
APPROVED BY: [Signature]  
AS APPROVED BY THE CITY OF AUSTIN  
ON BEHALF OF THE CITY OF AUSTIN

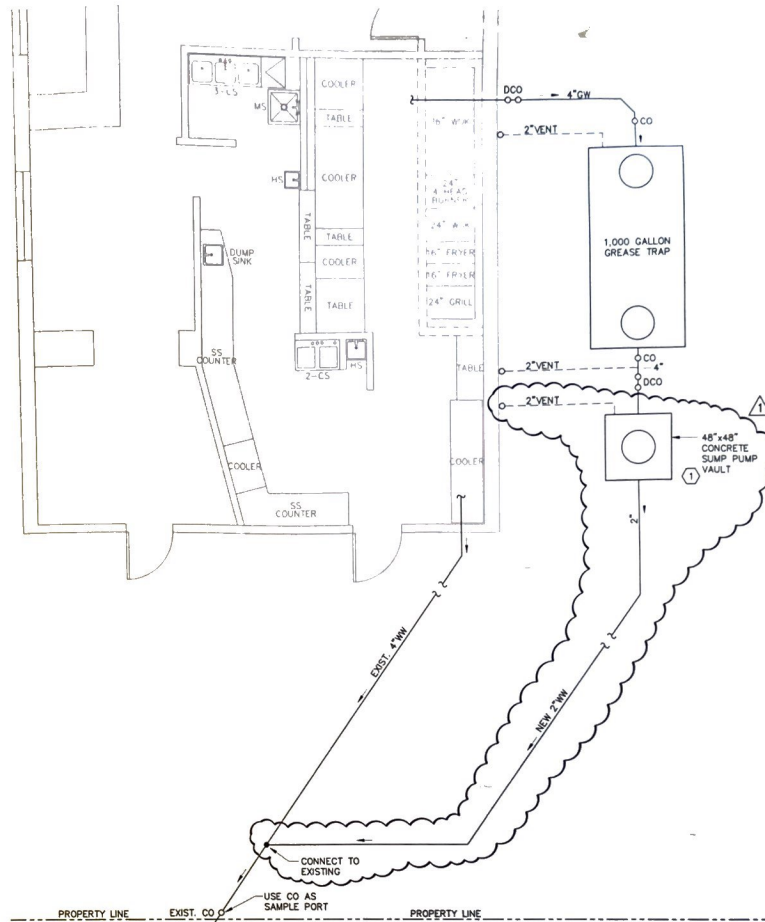

**1 WASTEWATER PLAN**  
SCALE: 1/4"=1'-0"

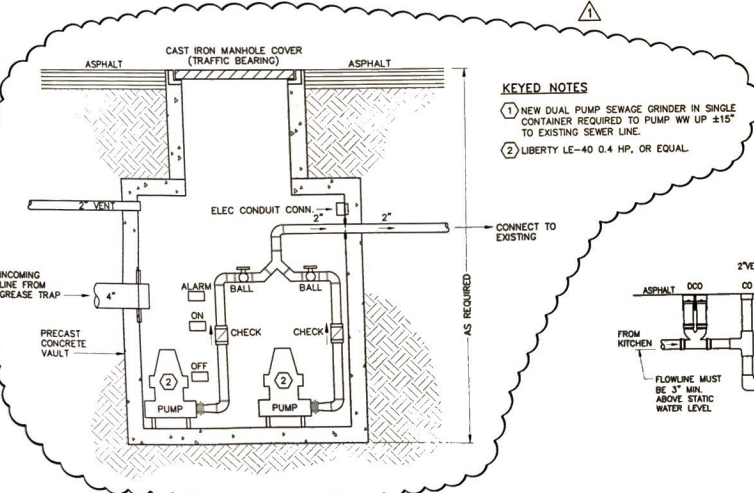

**2 ILLUSTRATIVE SEWAGE GRINDER DETAIL**  
SCALE: NONE

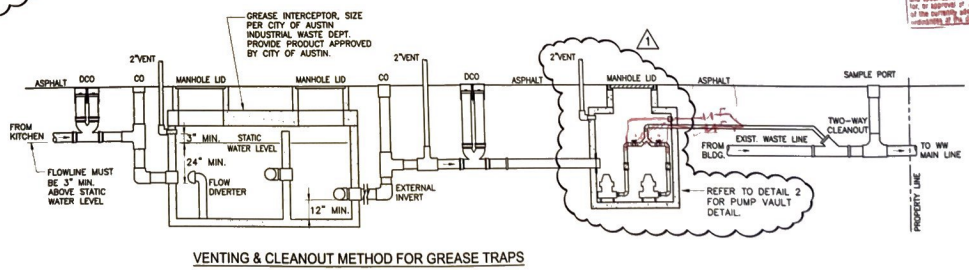

**3 VENTING & CLEANOUT METHOD FOR GREASE TRAPS**  
**VENTING DETAIL GREASE TRAP & SEWAGE GRINDER**  
SCALE: NONE

ALL PLUMBING SHALL BE IN ACCORDANCE WITH CITY OF AUSTIN ADOPTED PLUMBING CODES.  
REVIEWED: 2-7-19  
DATE: 2-7-19



**capt & smart**  
consulting engineers, inc.  
1200 Live Oak Rd.  
Leander, Texas 78641  
512.762.4407 phone  
Texas Registration #P-13532

**Austin  
Plans for Permits**  
1200 Live Oak Rd.  
Leander, TX 78641  
Cell: 512-844-5972  
c.b. ellis

**Tuk Tuk Thai Cafe**  
5517 Manchaca Rd.  
Austin, TX 78745

NO.	REVISION OR ISSUE	DATE
1	BUMP PUMP VAULT ADDED DUE TO ELEVATION ISSUES	1-31-19

**Wastewater Plan**

SHEET TITLE

DRAWN BY: [Signature] CHECKED BY: [Signature] DATE: 2-7-19

SCALE: 1"=1'-0"

PROJECT: Tuk Tuk Thai Cafe.dwg

**P1**

