


KEY PLAN

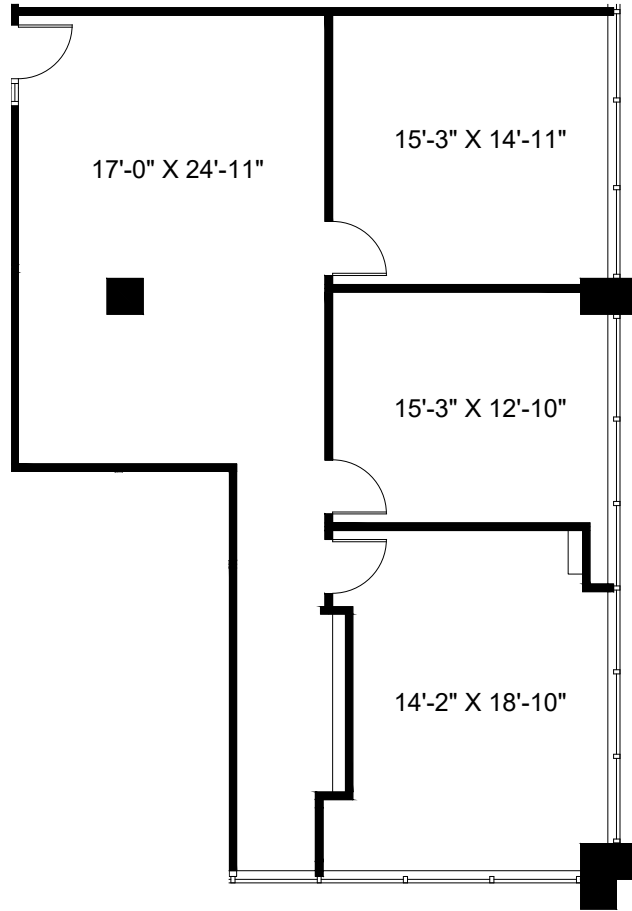

800 W. AIRPORT FREEWAY

IRVING, TEXAS 75062

AS-BUILT PLAN
SUITE 515

rsf:	1,604
scale:	1/8"=1'-0"
date:	01.26.2023



1201 main street
suite 1370
dallas, texas 75202
214.420.4646