


KEYNOTES	
Key Value	Keynote Text
2	THIN BRICK VENEER OVER 8x8x16 CMU
6	STEEL AWNING PER 3/A5.2 AND 24/A9.3
19	CONCRETE SLAB-ON-GRADE
33	PRIMARY ROOF DRAIN AND OVERFLOW PER PLUMBING DRAWINGS
53	PAVEMENT STRIPING
54	6" CONCRETE FILLED STEEL BOLLARDS
56	EDGE OF 6" CONCRETE STEP
58	WALL MOUNTED BIKE RACK PER SPEC 12 93 13 AND DETAILS
70	BIKE AIR PUMP APPLIANCE
85	TS COLUMN WRAPPED IN GFRP PER DETAIL 2/A9.03
100	BIKE WASH STATION
103	2"x10"x5" TALL TS POST FOR SUPPORT OF ELECTRIC CAR CHARGERS, w/ 4x15 BASE PLATE

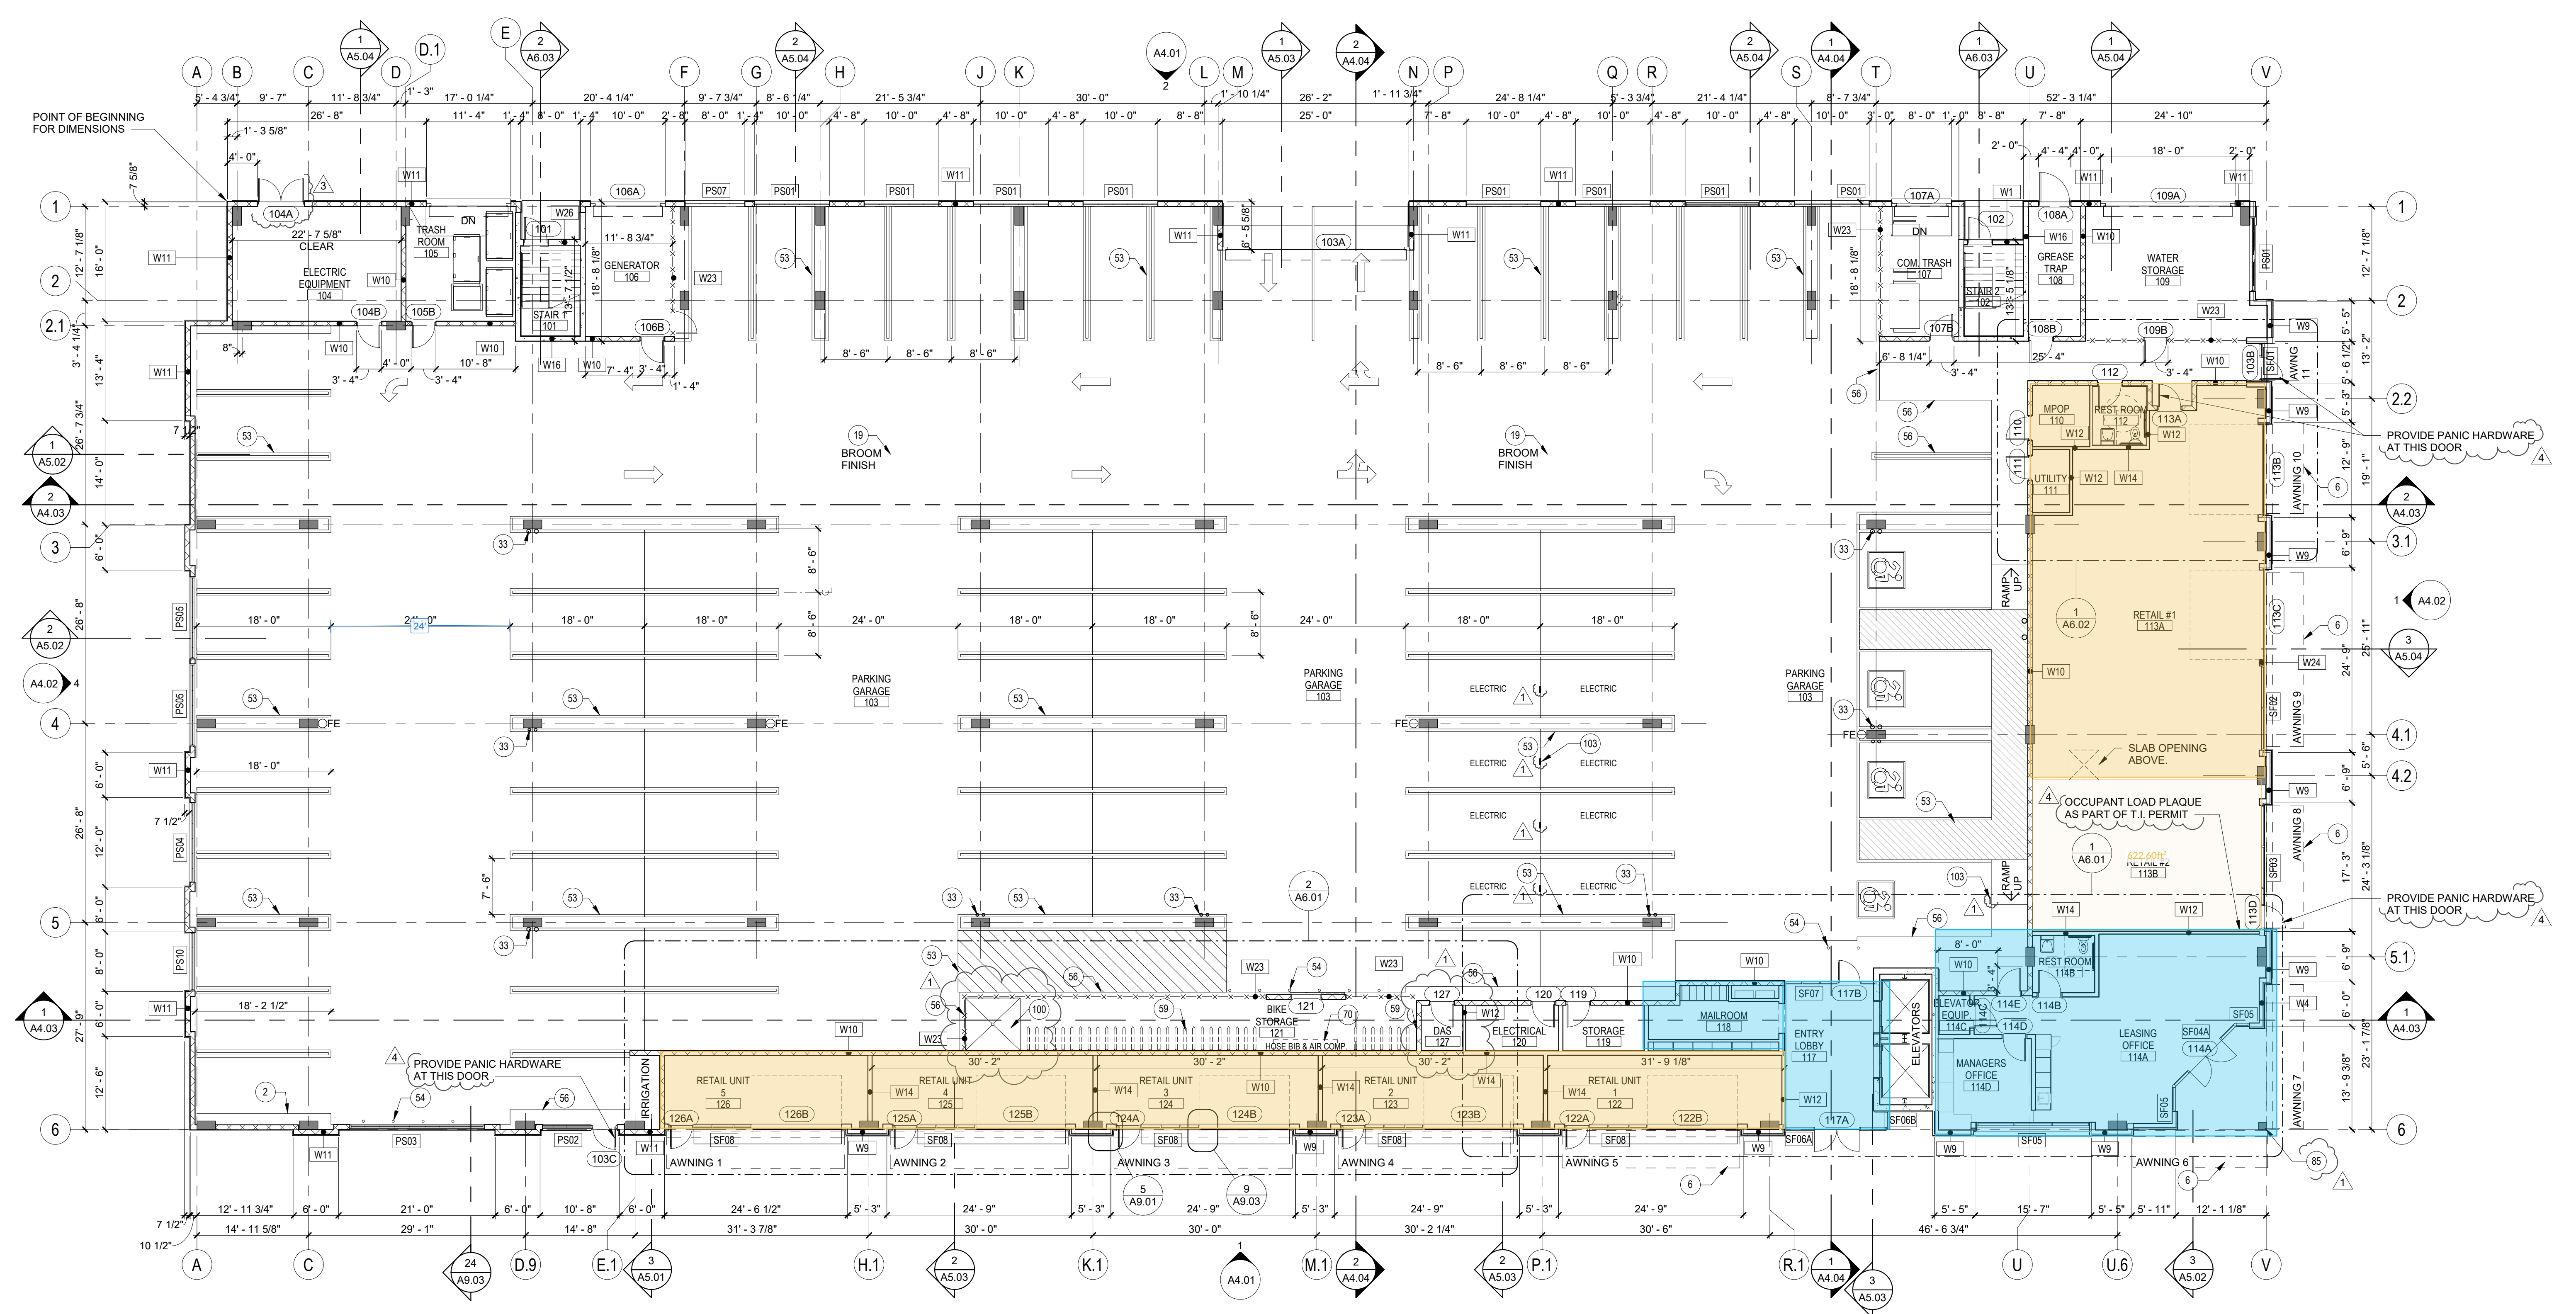

1 LEVEL 1
3/32" = 1'-0"

ECO-PHX APARTMENTS
Habitat Metro

301 WEST ROOSEVELT ST
PHOENIX AZ 85003

ISSUANCE

DATE	REV	FOR
09-03-2019	1	1st SUBMITTAL/BID SET
10-11-2019	1	ADDENDUM 01
11-01-2019	3	ARCHITECTURAL QC
11-01-2019	4	CITY COMMENTS
07-22-2021		INTERIM DIRECTIVE 26

Drawn
SP/TD
Checked
JG
Job Number
1717
Drawing
FIRST FLOOR PLAN

Sheet
A2.01