


January 15, 2018
18M22.CB



VACANCY – KUYKENDAHL PLAZA

Suite 220 2,060 NRSF
17207 Kuykendahl Rd.
Spring TX 77379

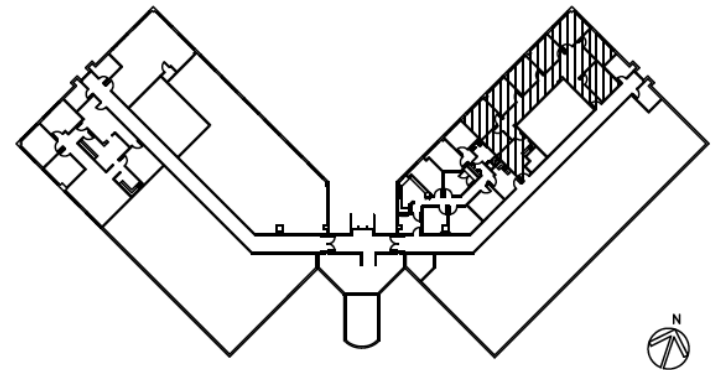

CIVET

Real Estate

713.222.4838

713.22.CIVET

audra@civetrealestate.com