



1 TENANT REFLECTED CEILING PLAN - AS-BUILT
1/4" = 1'-0"

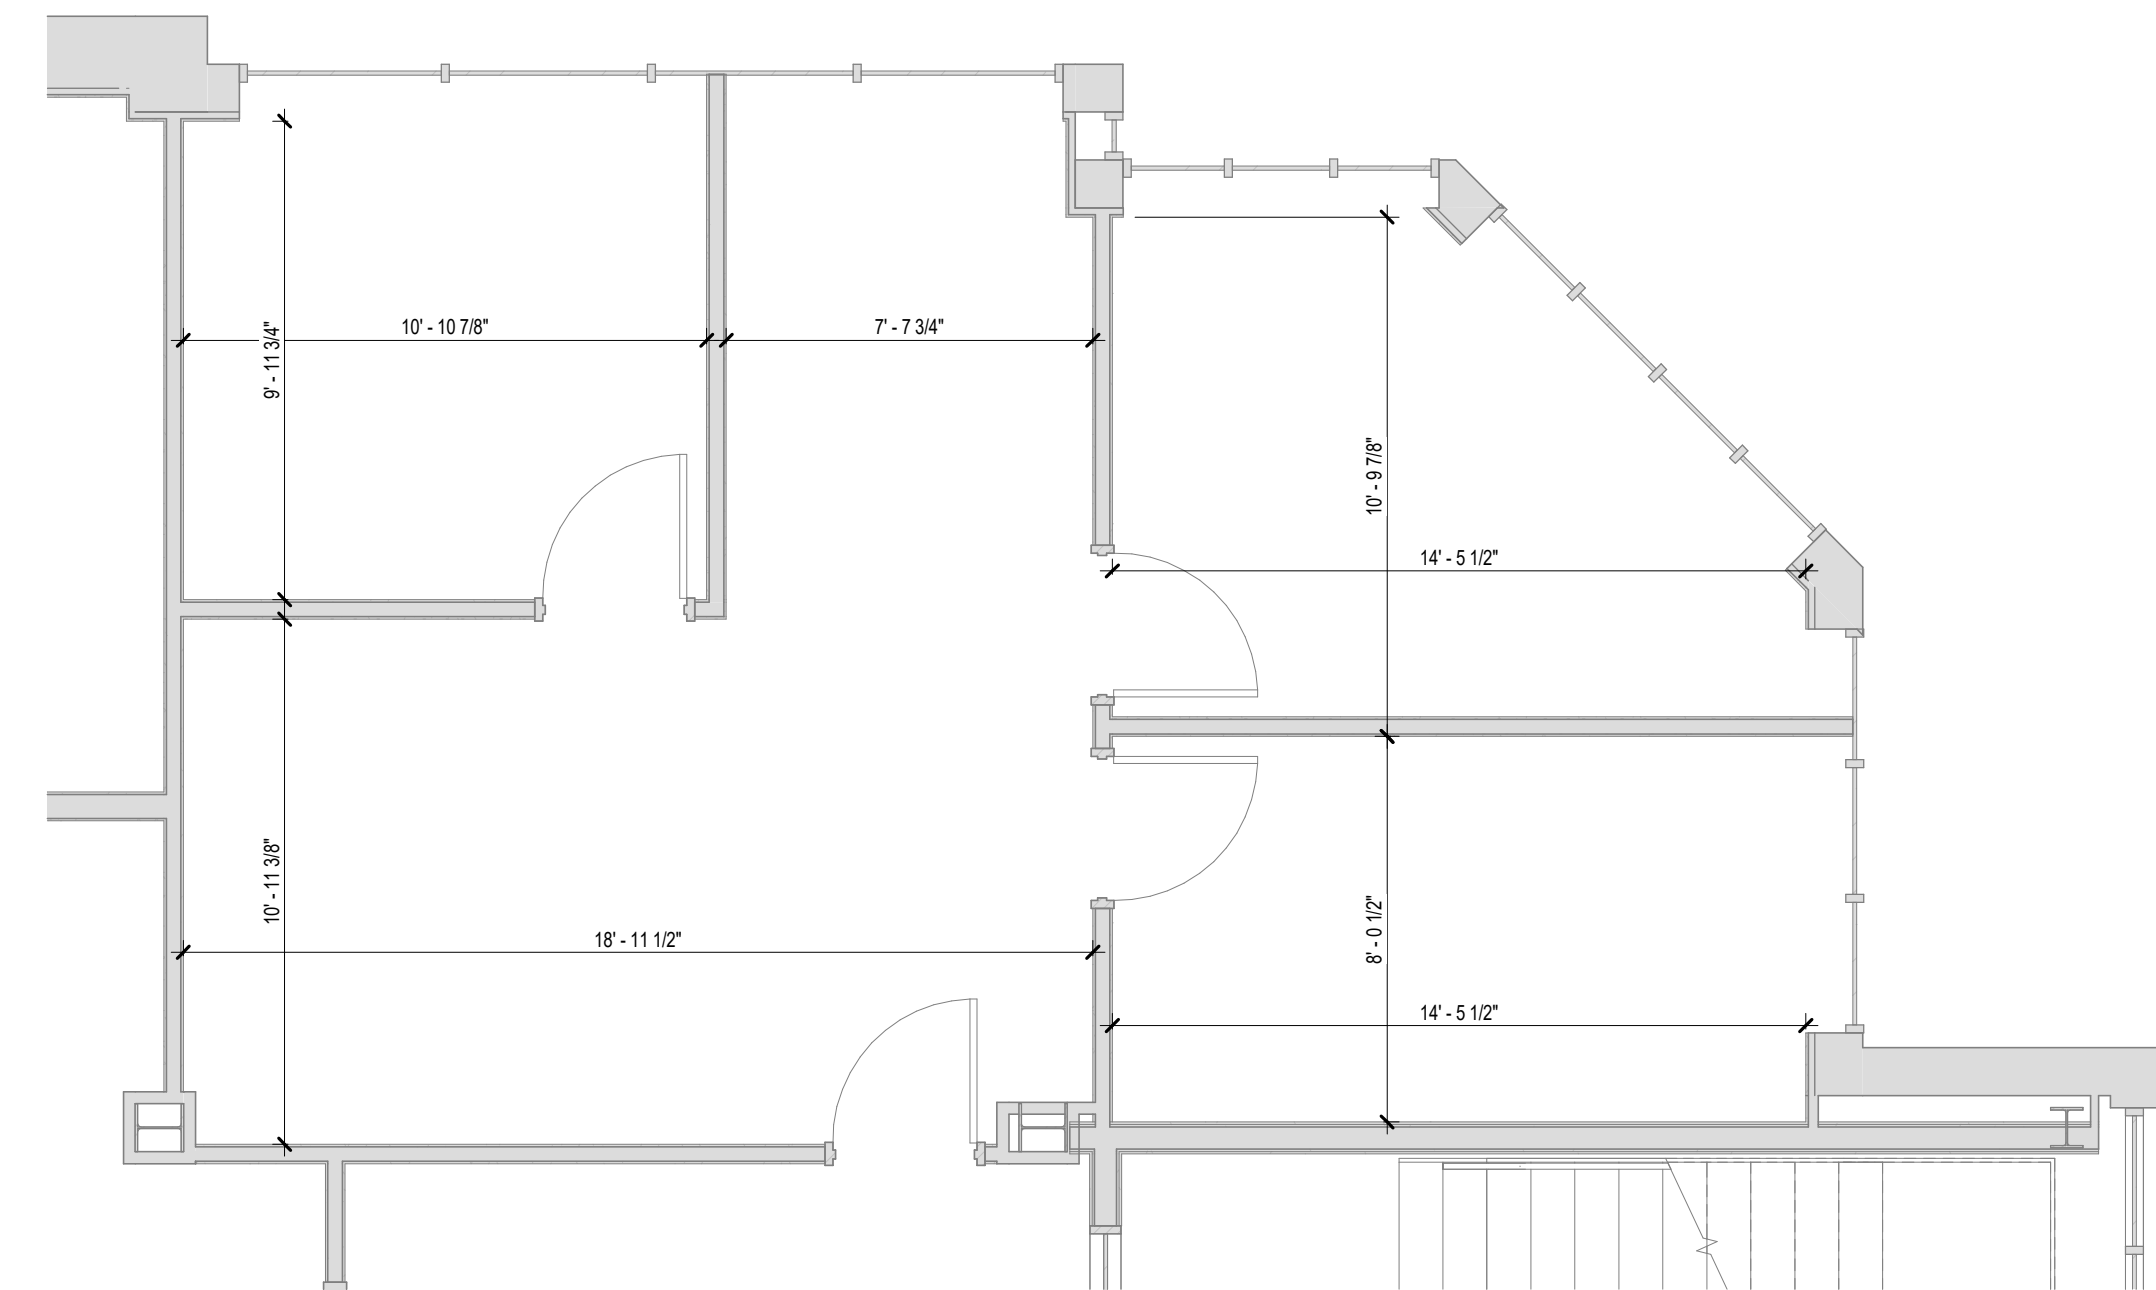

2 TENANT FLOOR PLAN - AS-BUILT
1/4" = 1'-0"

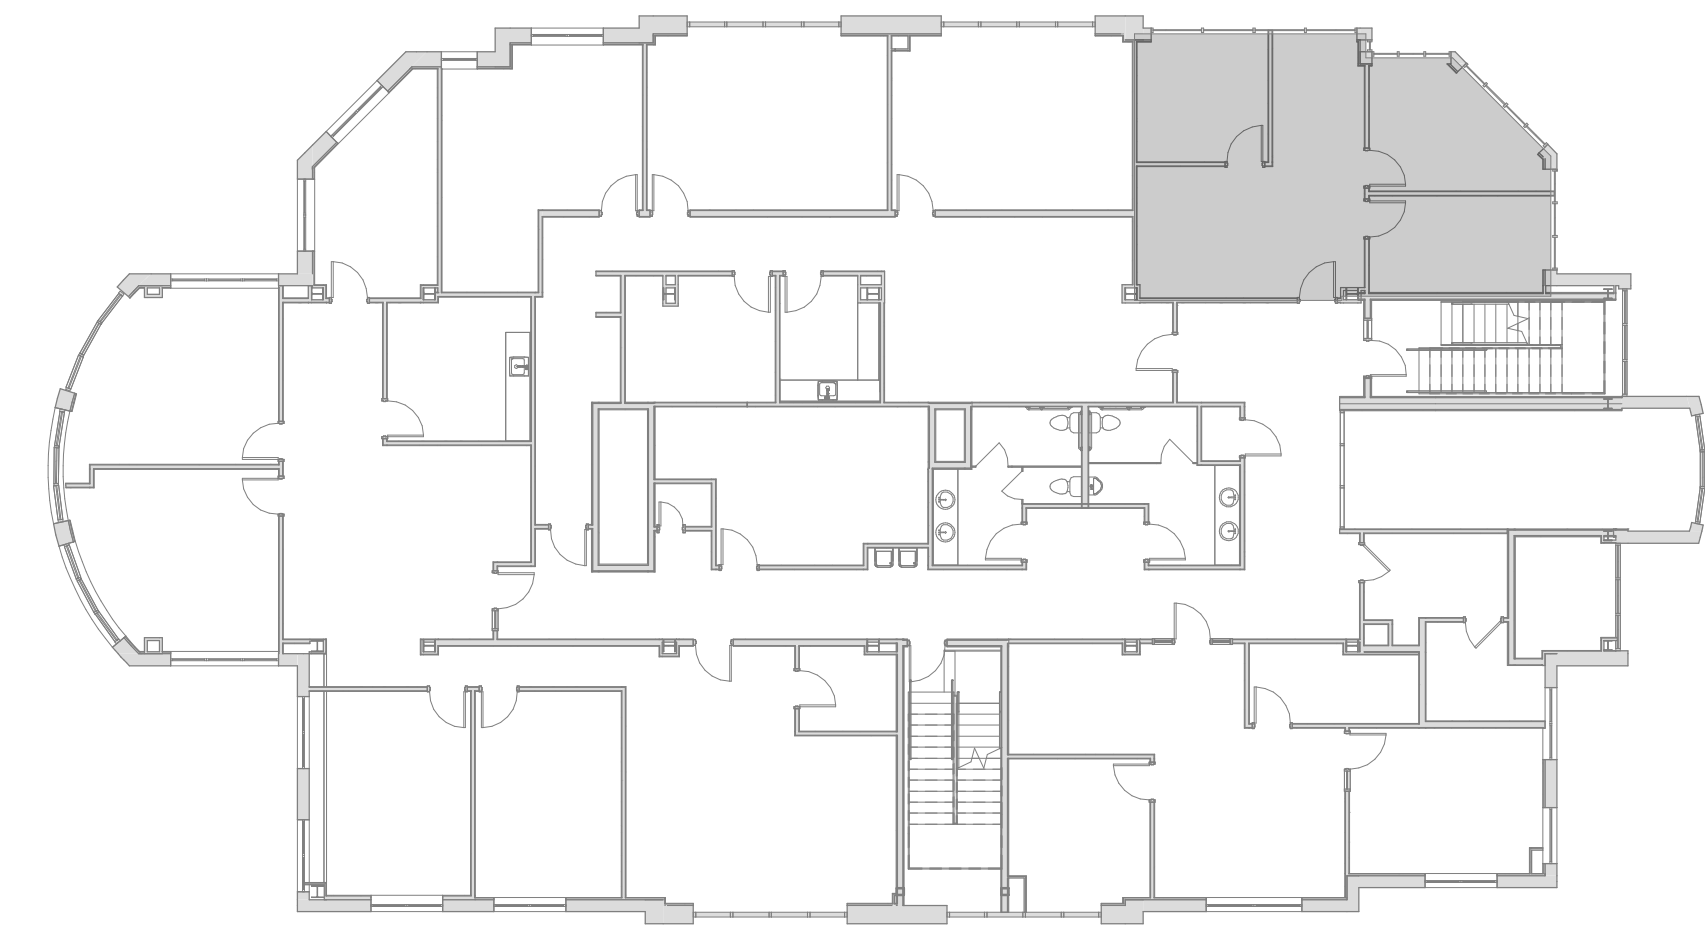

2ND FLOOR KEY PLAN

AS-BUILT PLAN

ONB BUILDING OWNERS ASSOCIATION
975 34th AVE NW, ROCHESTER, MN 55901

SHEET NO.
A2.3

DATE: 03-17-2026
SCALE: AS NOTED
DRAWN BY: AJM
CHECKED BY: DJH
JOB NUMBER: 2024-10808

DATE	REV#	REVISIONS DESCRIPTION

BY: I HEREBY CERTIFY THAT THIS PLAN, SPECIFICATION, OR REPORT WAS PREPARED BY ME OR UNDER MY DIRECT SUPERVISION AND THAT I AM A LICENSED ARCHITECT UNDER THE LAWS OF THE STATE OF MINNESOTA.
DATE: 03-17-2026
SIGNATURE: DANA J. HLEBICHUK
LICENSE NUMBER: LC# 44719