


SUITE 550

SUITE 500
 AVAILABLE
 1989 RSF

SUITE 520

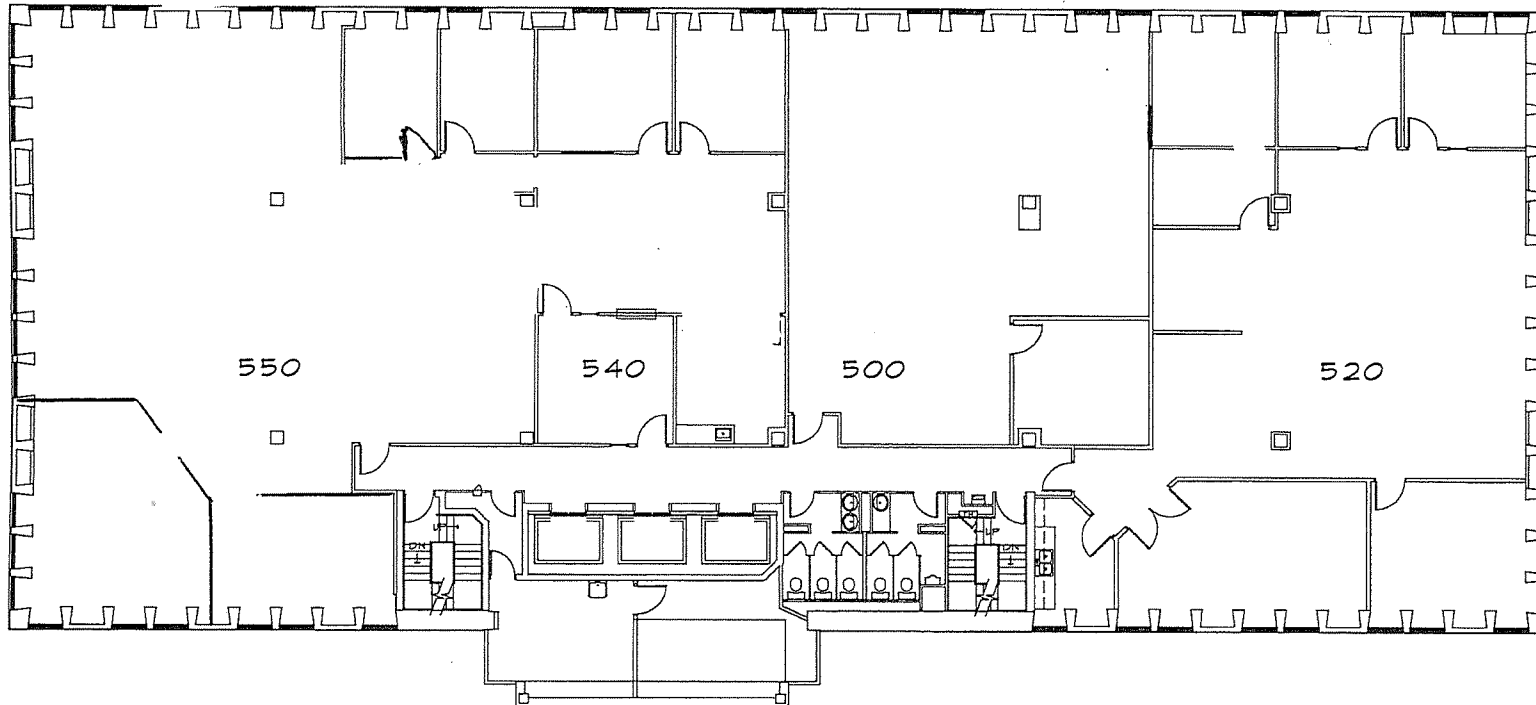

**5TH FLOOR
 PLAN**

SOUTHLAND
 TOWER
 5TH FLOOR



10.25.2019

AS-BUILT
 PLAN

AS.5

A FLOOR PLAN 
 SCALE: N.T.S. NORTH