
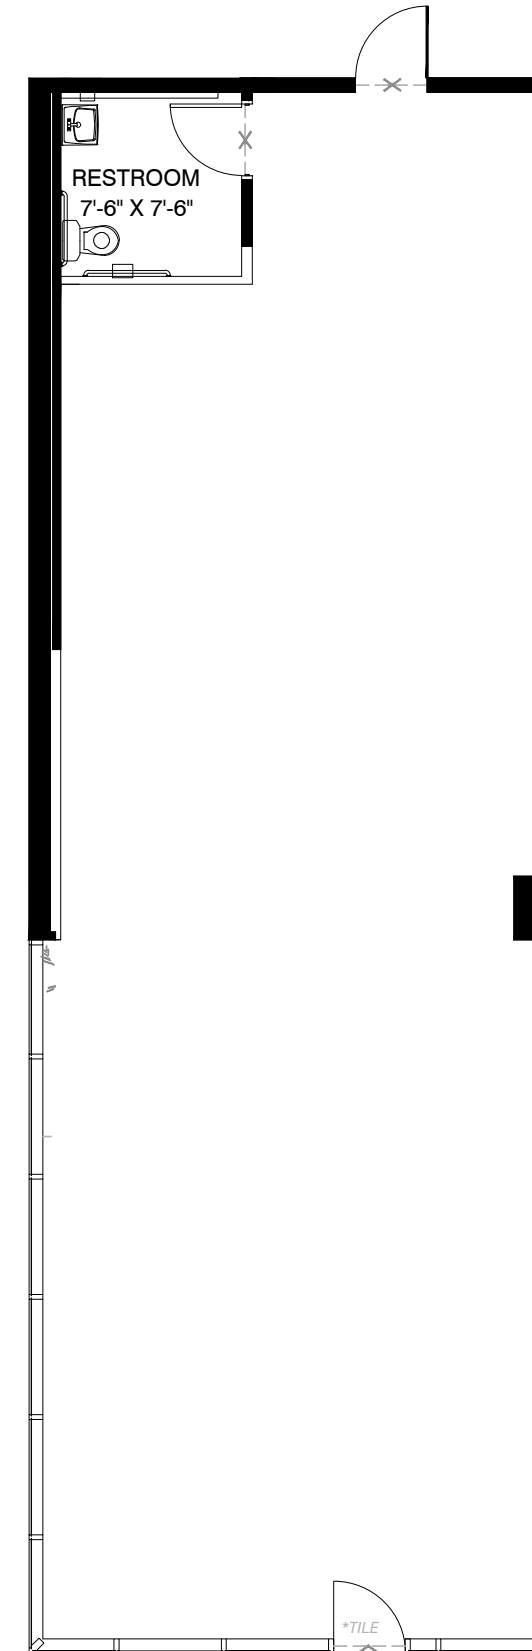


**LEASING TEAM CONTACT:**

KOLBY DICKERSON - 214.534.1599  
kdickerson@txreproperties.com

SAM DAVIS - 214.684.7197  
sdavis@txreproperties.com

GRANT GOMEZ - 214.734.4725  
grant@txreproperties.com

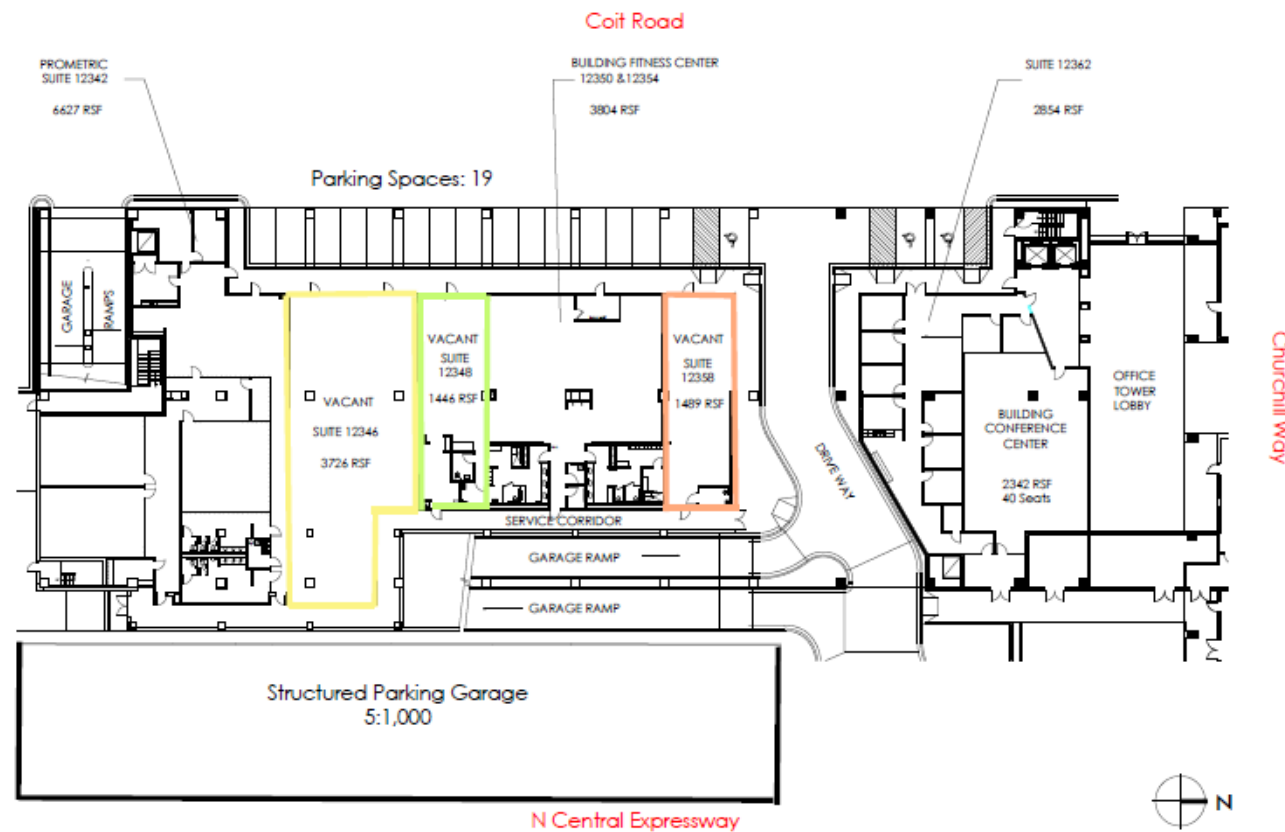

**SUITE 12358 | 1,489 RSF  
AS-BUILT**



**CHURCHILL TOWER**  
12400 COIT RD. DALLAS, TX 75251

SUITE #12358 1,489 RSF

