


1

Reduced As-built

Suite 909

Scale: 1/8" = 1'-0"

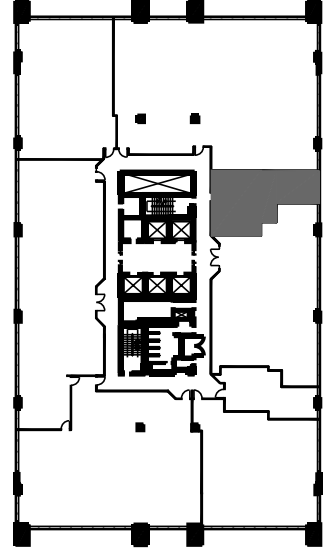

Proximity Plan

Suite 909

The Chancery

937 RSF

Reduced As-built Plan
 Issued: March 2025
 Drawn by: MCP / WCS
 TPS Project #: 171001

The Chancery
 Level Nine, Suite 909
 1120 Lincoln Street
 Denver, Colorado

