

LAKES
MEDICAL
PLAZA

10474 W THUNDERBIRD BLVD | SUN CITY, AZ 85351


Floor 02

Suite
200/201

AS-BUILT

16,735 SF

AVAILABLE

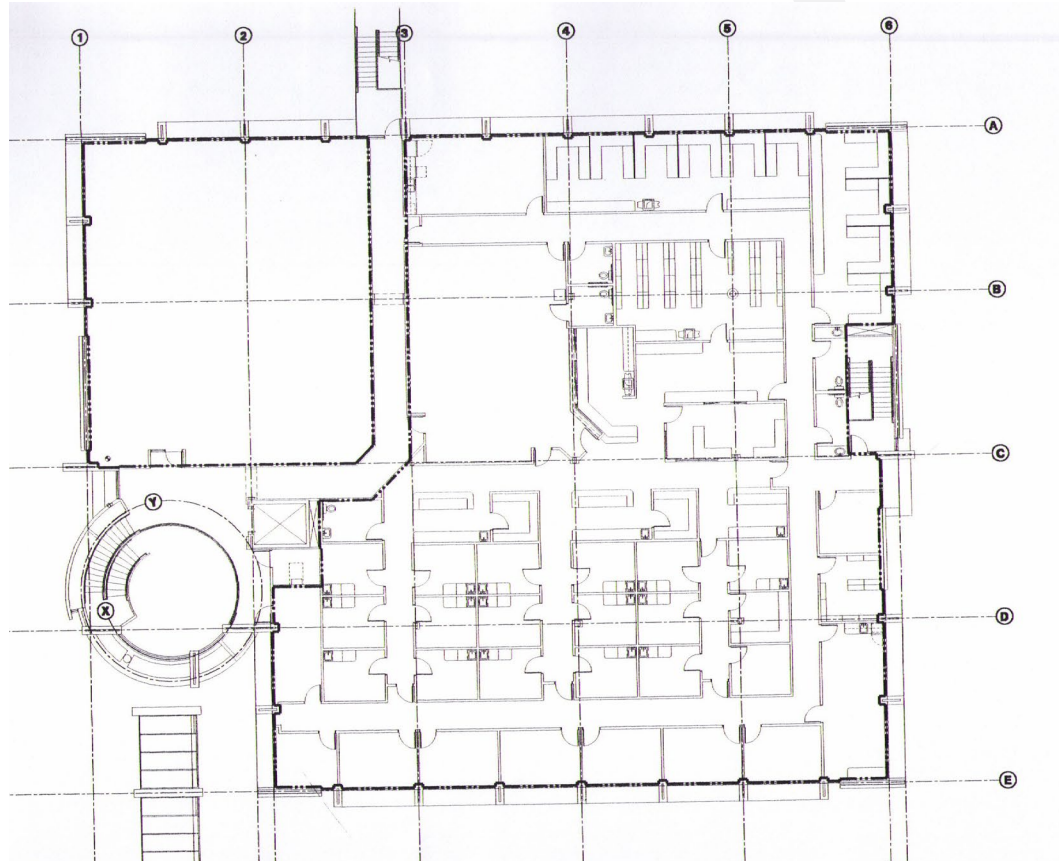

RACHAEL THOMPSON
Senior Vice President
602.513.5122
rachael.thompson@kidder.com

PERRY GABUZZI, CCIM
Executive Vice President
602.513.5116
perry.gabuzzi@kidder.com



View Portfolio

km Kidder
Mathews