

DESERT RIDGE
MEDICAL CAMPUS
BUILDING B


Floor 02

Suite 270

AS-BUILT

3,298 SF

AVAILABLE

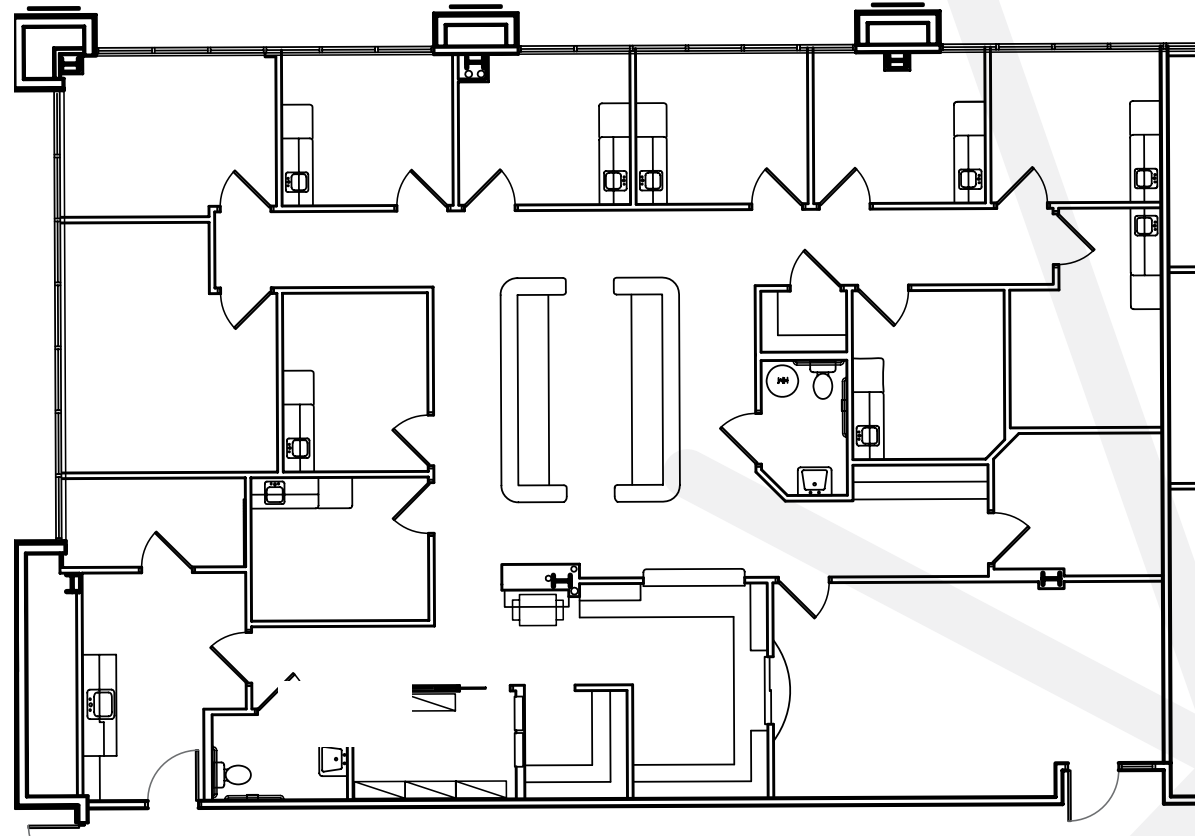

RACHAEL THOMPSON
Senior Vice President
602.513.5122
rachael.thompson@kidder.com

PERRY GABUZZI, CCIM
Executive Vice President
602.513.5116
perry.gabuzzi@kidder.com



View Portfolio