


THUNDERBIRD MEDICAL PLAZA III

Floor 01

Suite 103
AS-BUILT

1,319 SF
AVAILABLE

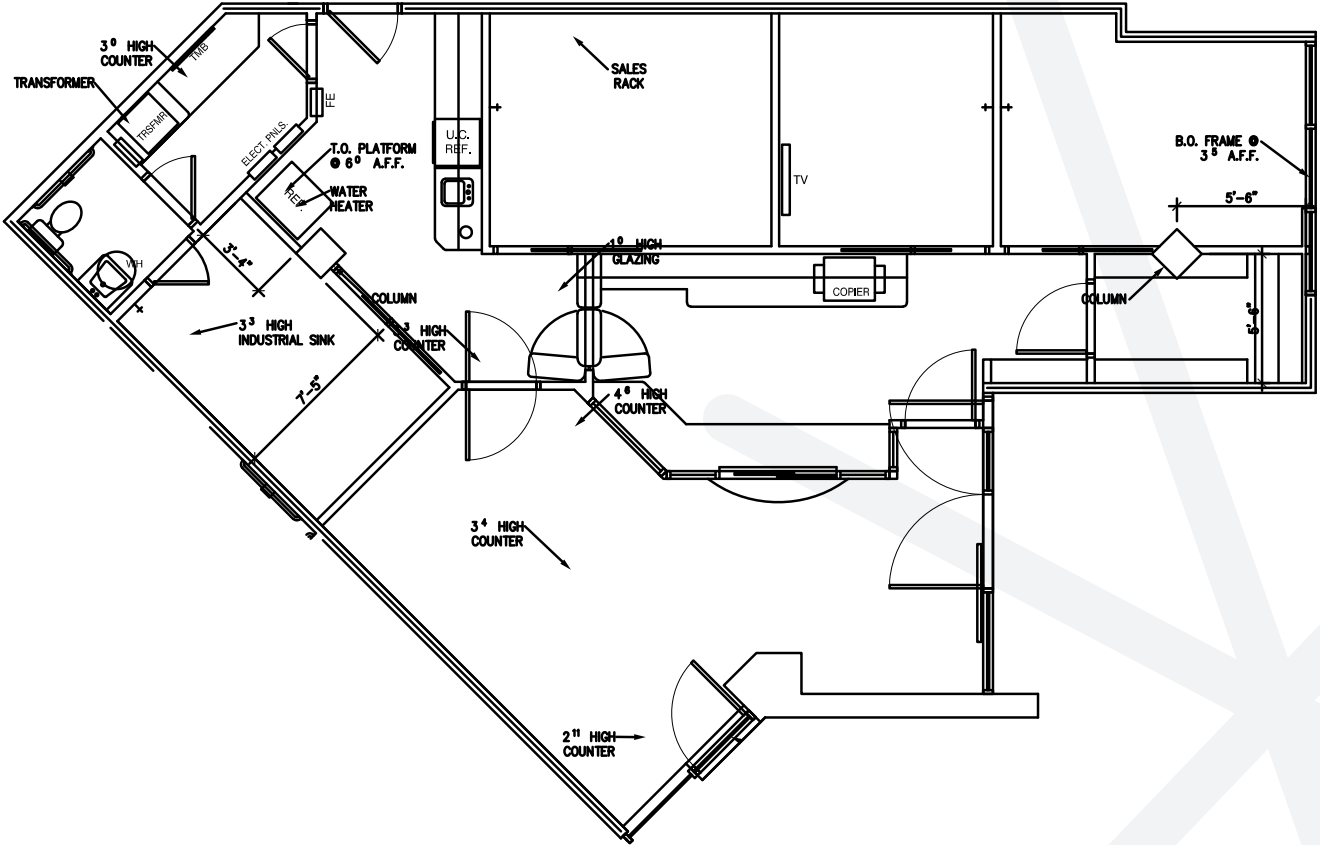

RACHAEL THOMPSON
Senior Vice President
602.513.5122
rachael.thompson@kidder.com

PERRY GABUZZI, CCIM
Executive Vice President
602.513.5116
perry.gabuzzi@kidder.com