




"AS BUILT" DRAWING
MEASURED BY MR LLC

EXHIBIT A

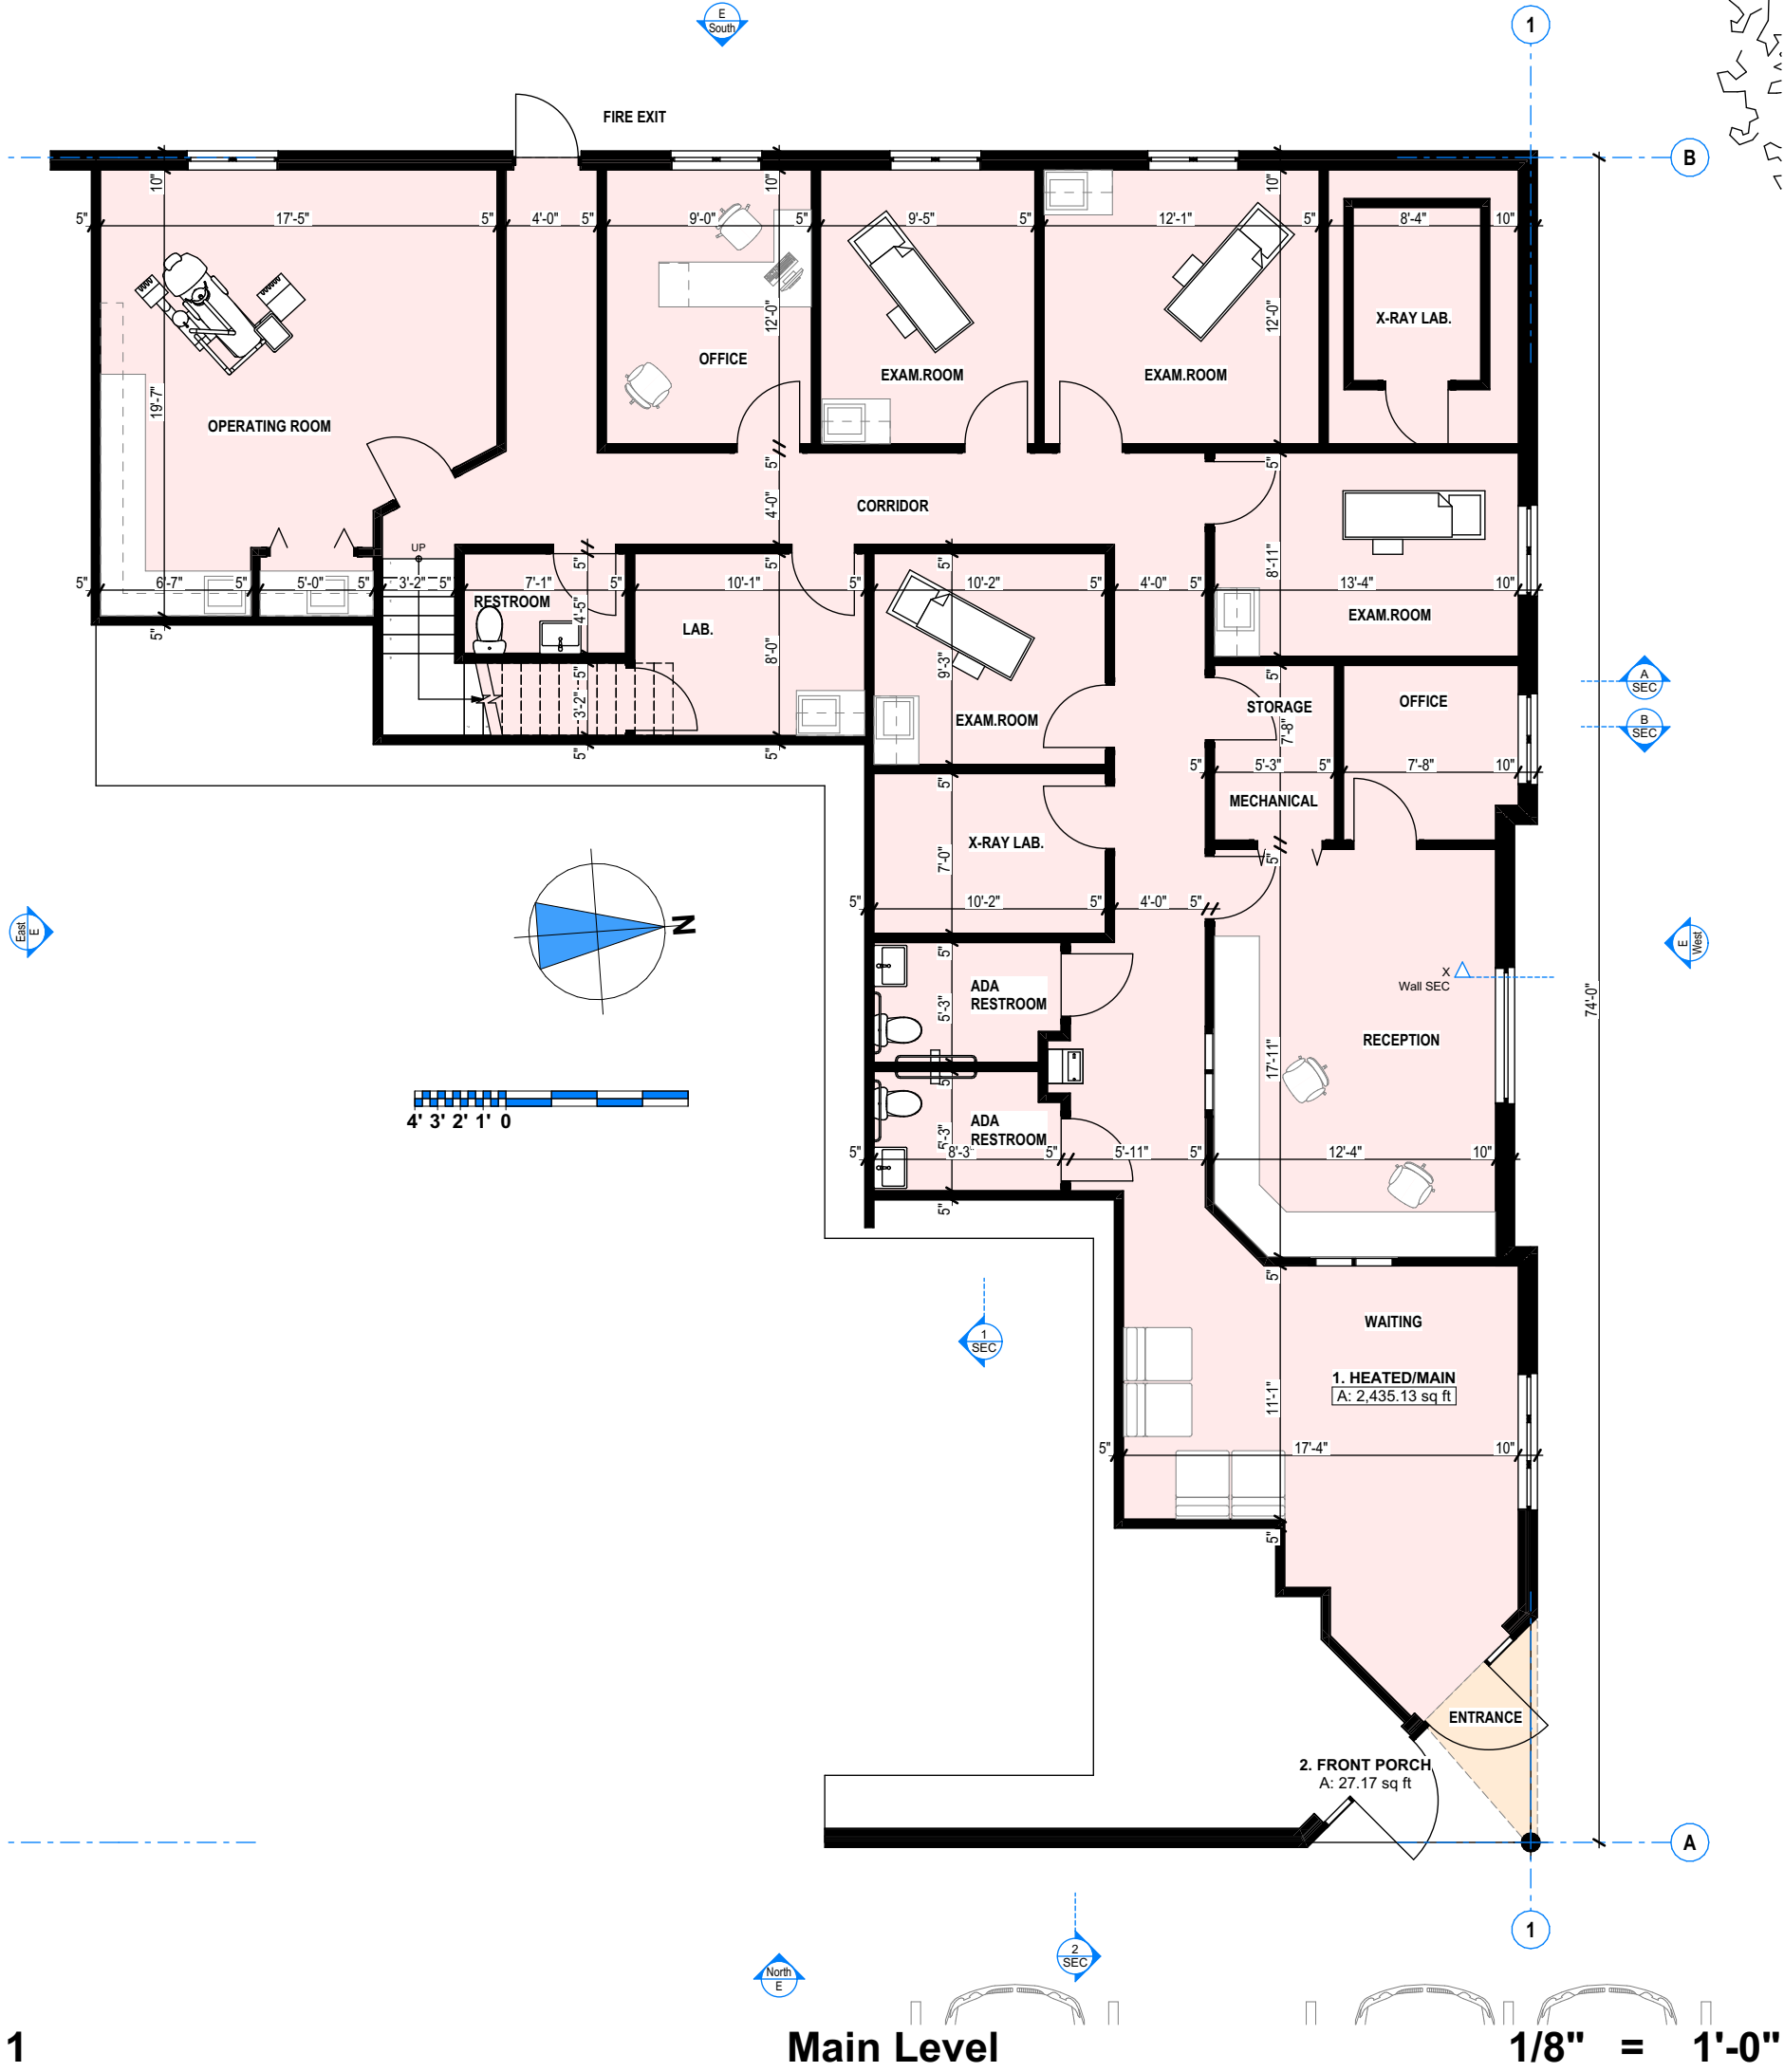

Room Schedule				
Label		Room Name	Area	Type
FLOOR AREA				
	Main Level	1. HEATED/MAIN	2,435.13	Commercial Heated
	Main Level	2. FRONT PORCH	27.17	External / Covered
			2,462.30 sq ft	
	Upper Floor	1. HEATED/UPPER	1,088.37	Commercial Heated
			1,088.37 sq ft	
			3,550.67 sq ft	

2 Room Schedule 1' = 1'-0"

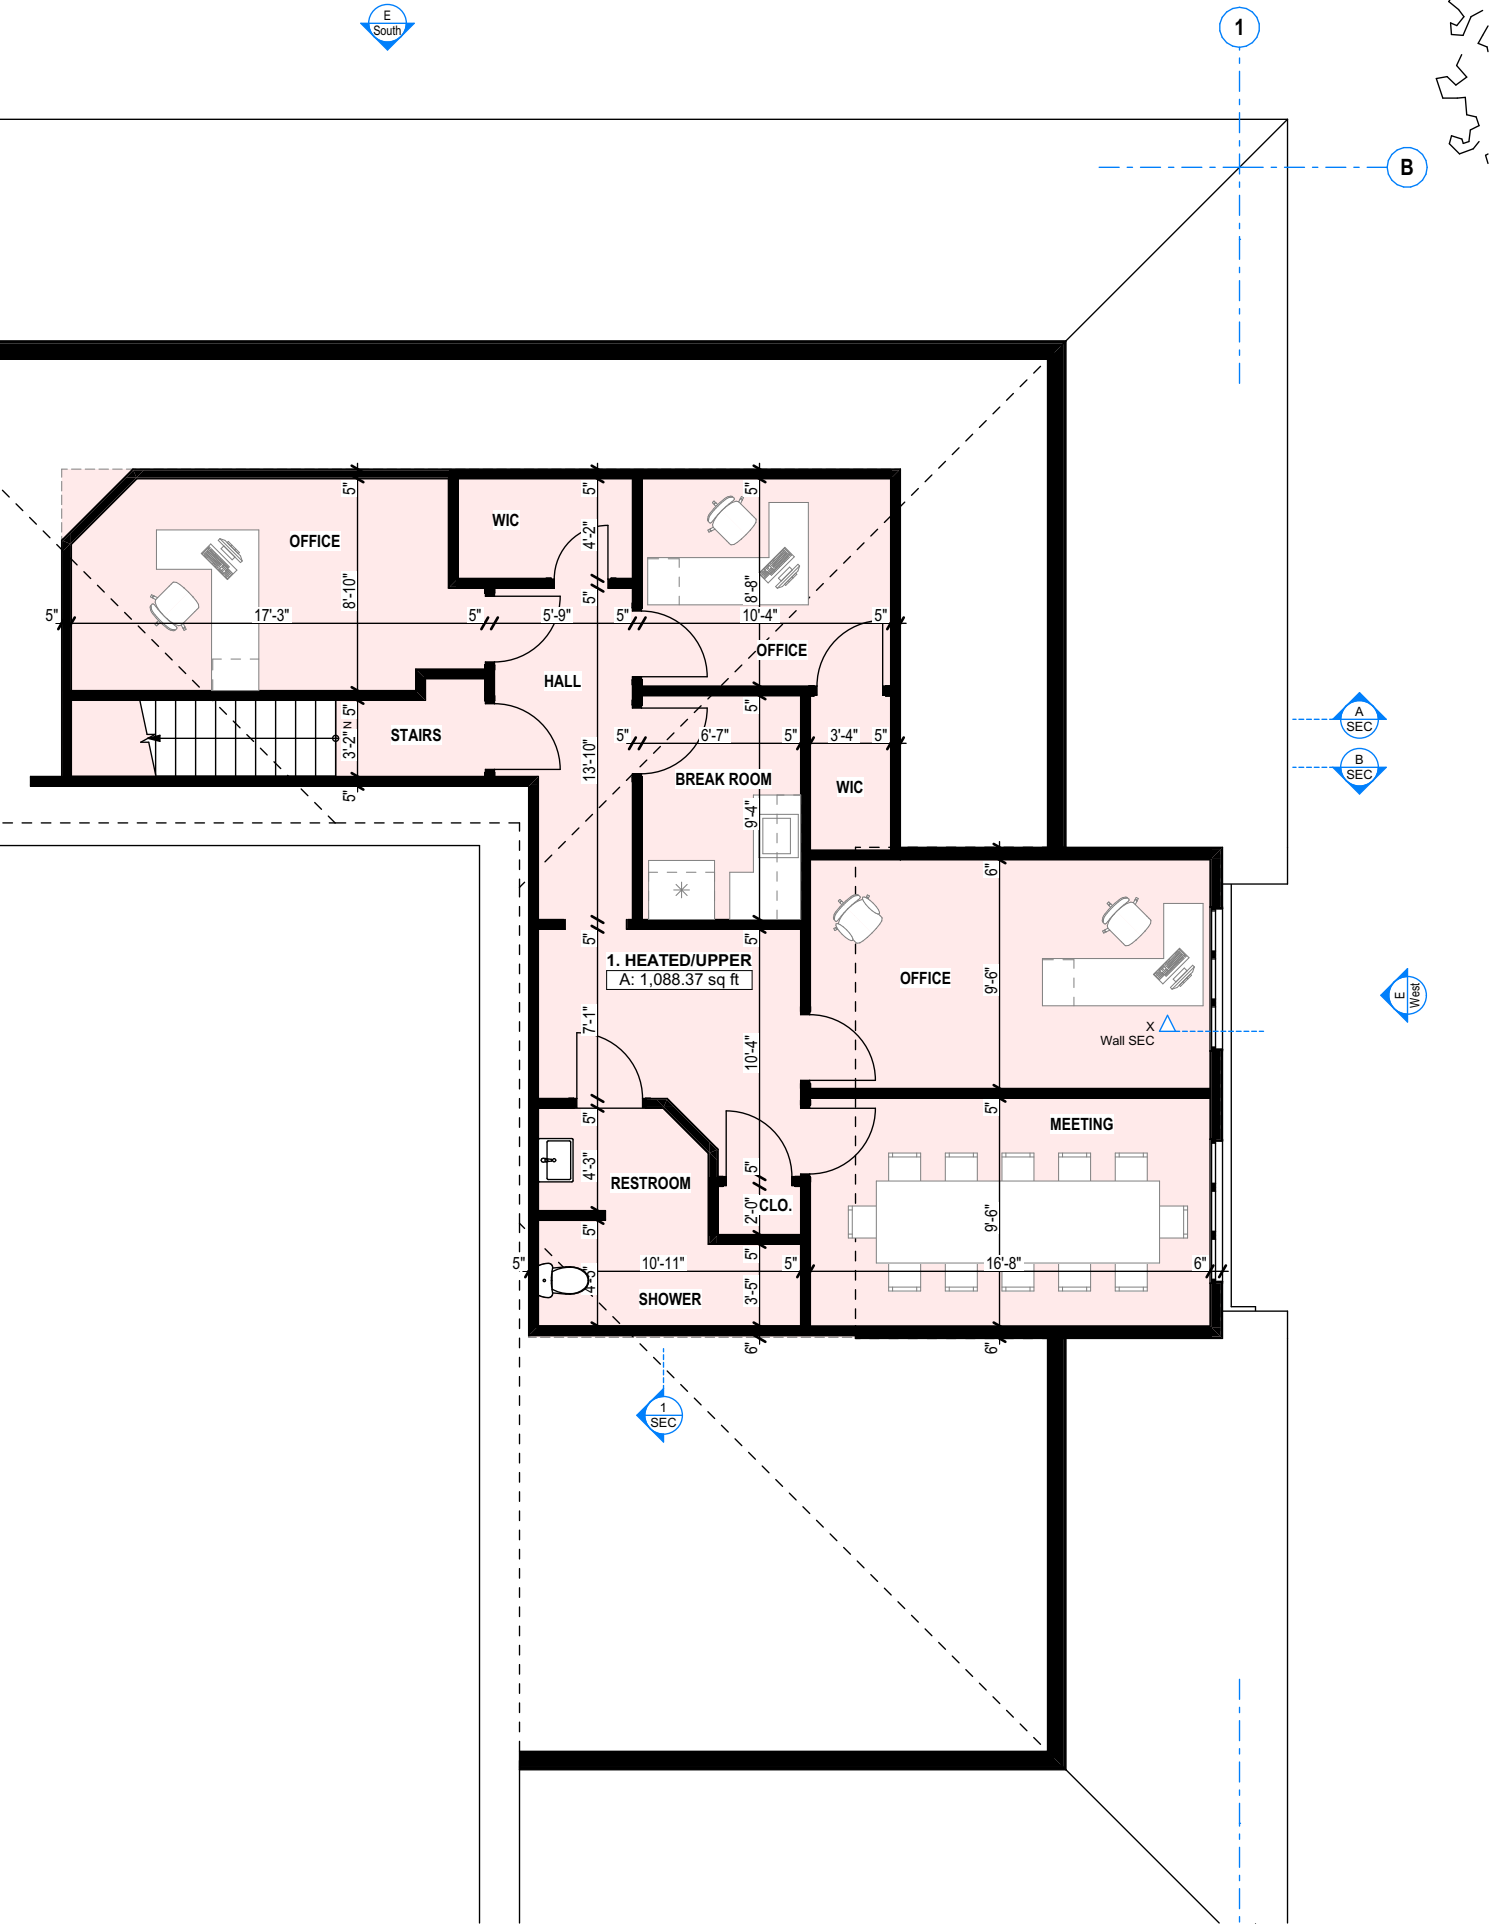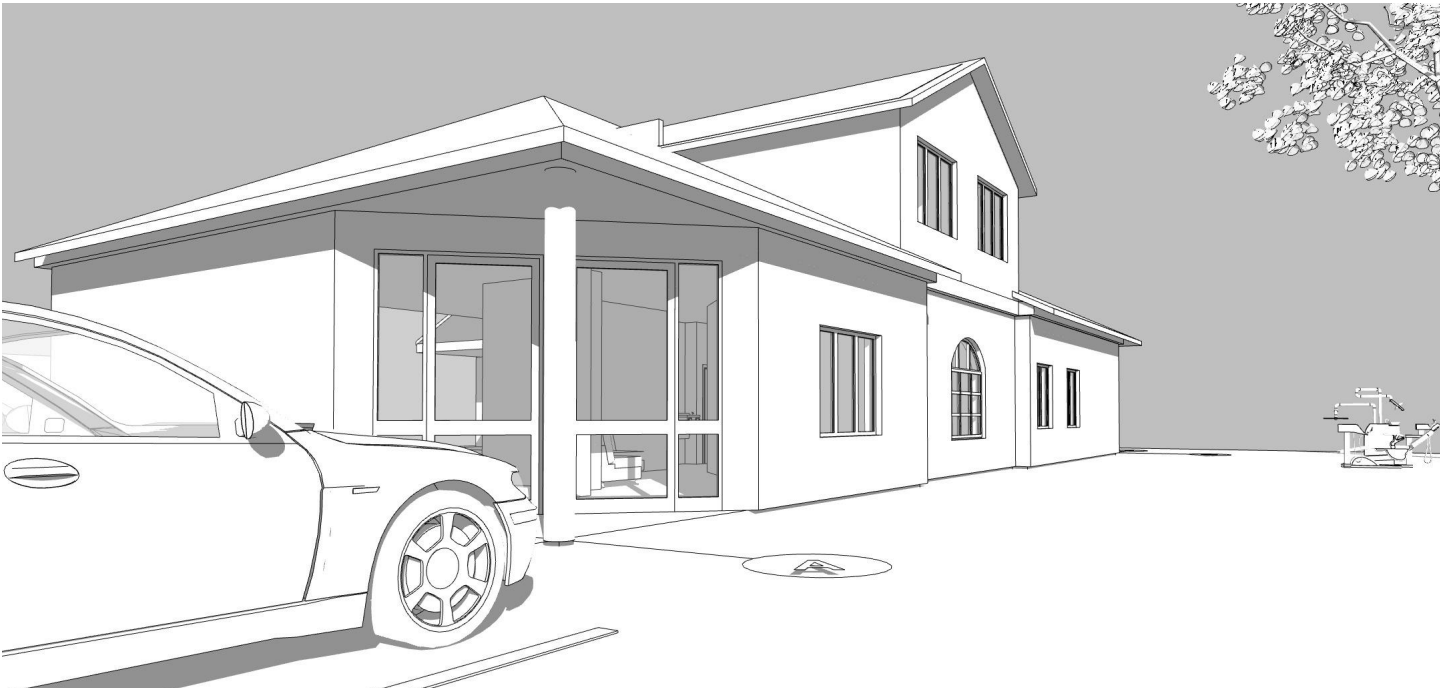

PROJECT LOCATION MAP


GENERAL NOTES:
1. DO NOT USE AS A BLUEPRINTS WITHOUT MR LLC PERMISSION.
2. PLEASE NOTE INTERIOR DIMENSIONS WERE NOT USED IN CALCULATING SQUARE FOOTAGE
3. SIZE OF HEATED AND NOT HEATED AREA AND OTHER INFORMATION WERE OBTAINED PER THE NC REAL ESTATE COMMISSION GUIDELINES (6" FOR EXTERNAL WALLS EXCEPT CONDOMINIUMS)
4. FOR REMODELING QUESTIONS OR MORE DETAILED CAD DRAWINGS (INC.SITE PLAN, SECTIONS, ELEVATIONS) ALSO 3D MODEL PLEASE CONTACT ALFRED ZALYS
MOB. 828 231 7305 E-MAIL: A.ZALYS@HOTMAIL.COM

Revision History

RevID	ChID	Change Name	Date

LEGEND MAP:
HEATED RESIDEN.FINISHED
HEATED COMMERC.FINISHED
NOT HEATED/NOT FINISHED
OPEN DECK
COVERED PORCH

Client:
First and First Last
e-mail address
phone number

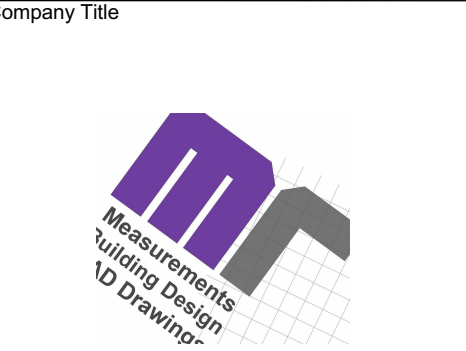

Company
Measure Rite LLC
103. Hendersonville
USA 28739

Site Address
**7 Walden Ridge Dr, Asheville,
NC 28803**

Drawing Name
**Main Level, Room Schedule,
Upper Floor, Generic
Perspective (1)**

Drawing Status
AS Built

Contact Name
Alfred ZALYS
mob. 828 231 7305

Job Nr.
MR 1047
Date
11/21/2023

Drawing Scale
1/8" = 1'-0", 1" = 1'-0", 1/32" = 1'-0"

Layouts Total
2
Paper Size
ANSI B

Layout ID
.2

Revision