


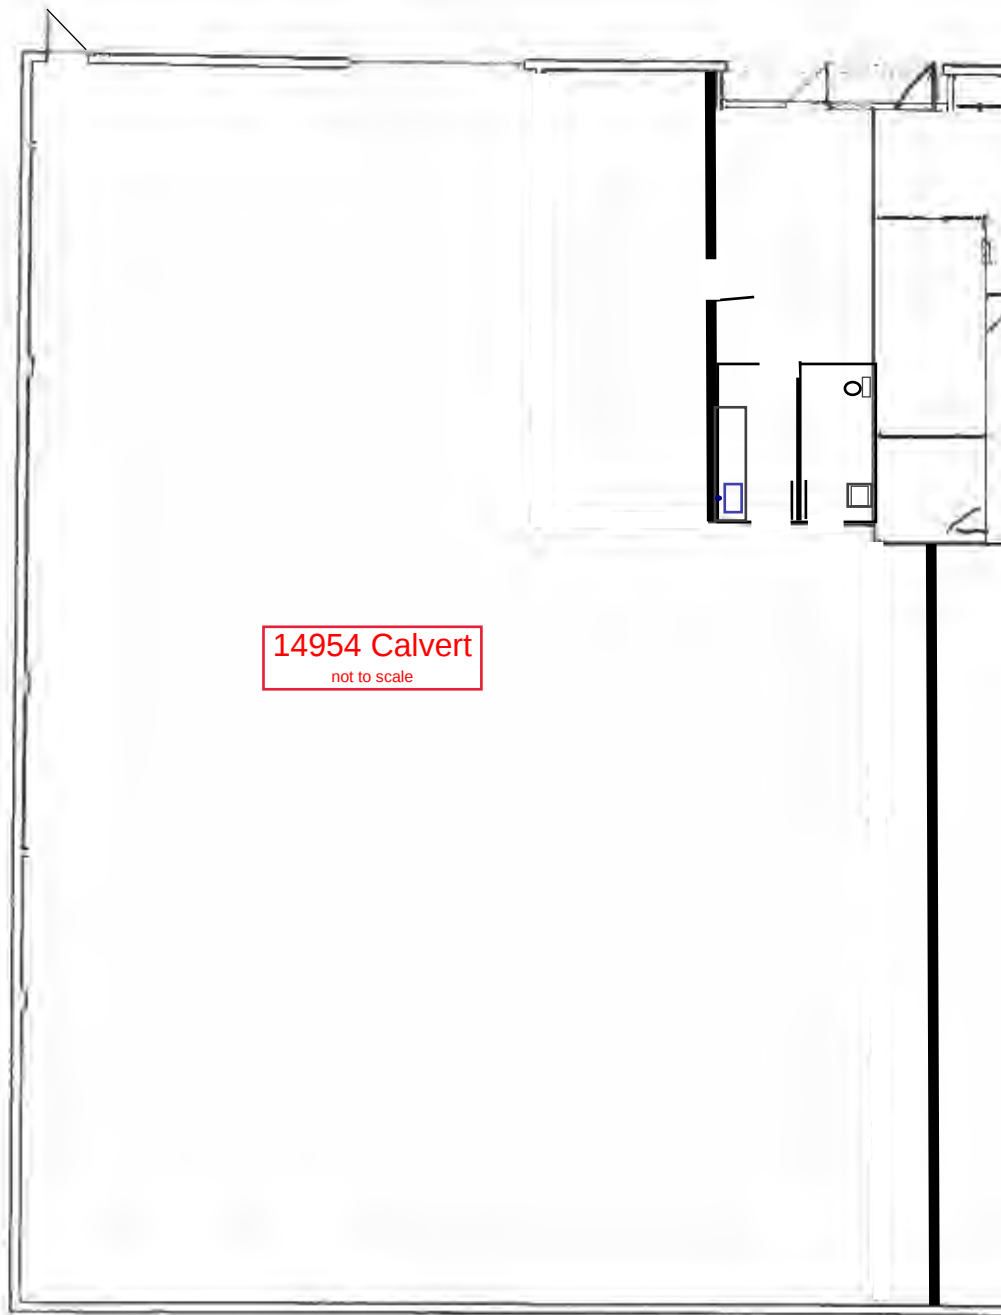

14954 Calvert

not to scale