


Piper-Wind Architects, Inc. 10114202119316AA 1:\Users\Project\Blue Ridge Tower\Fourth Floor of Floor Plan

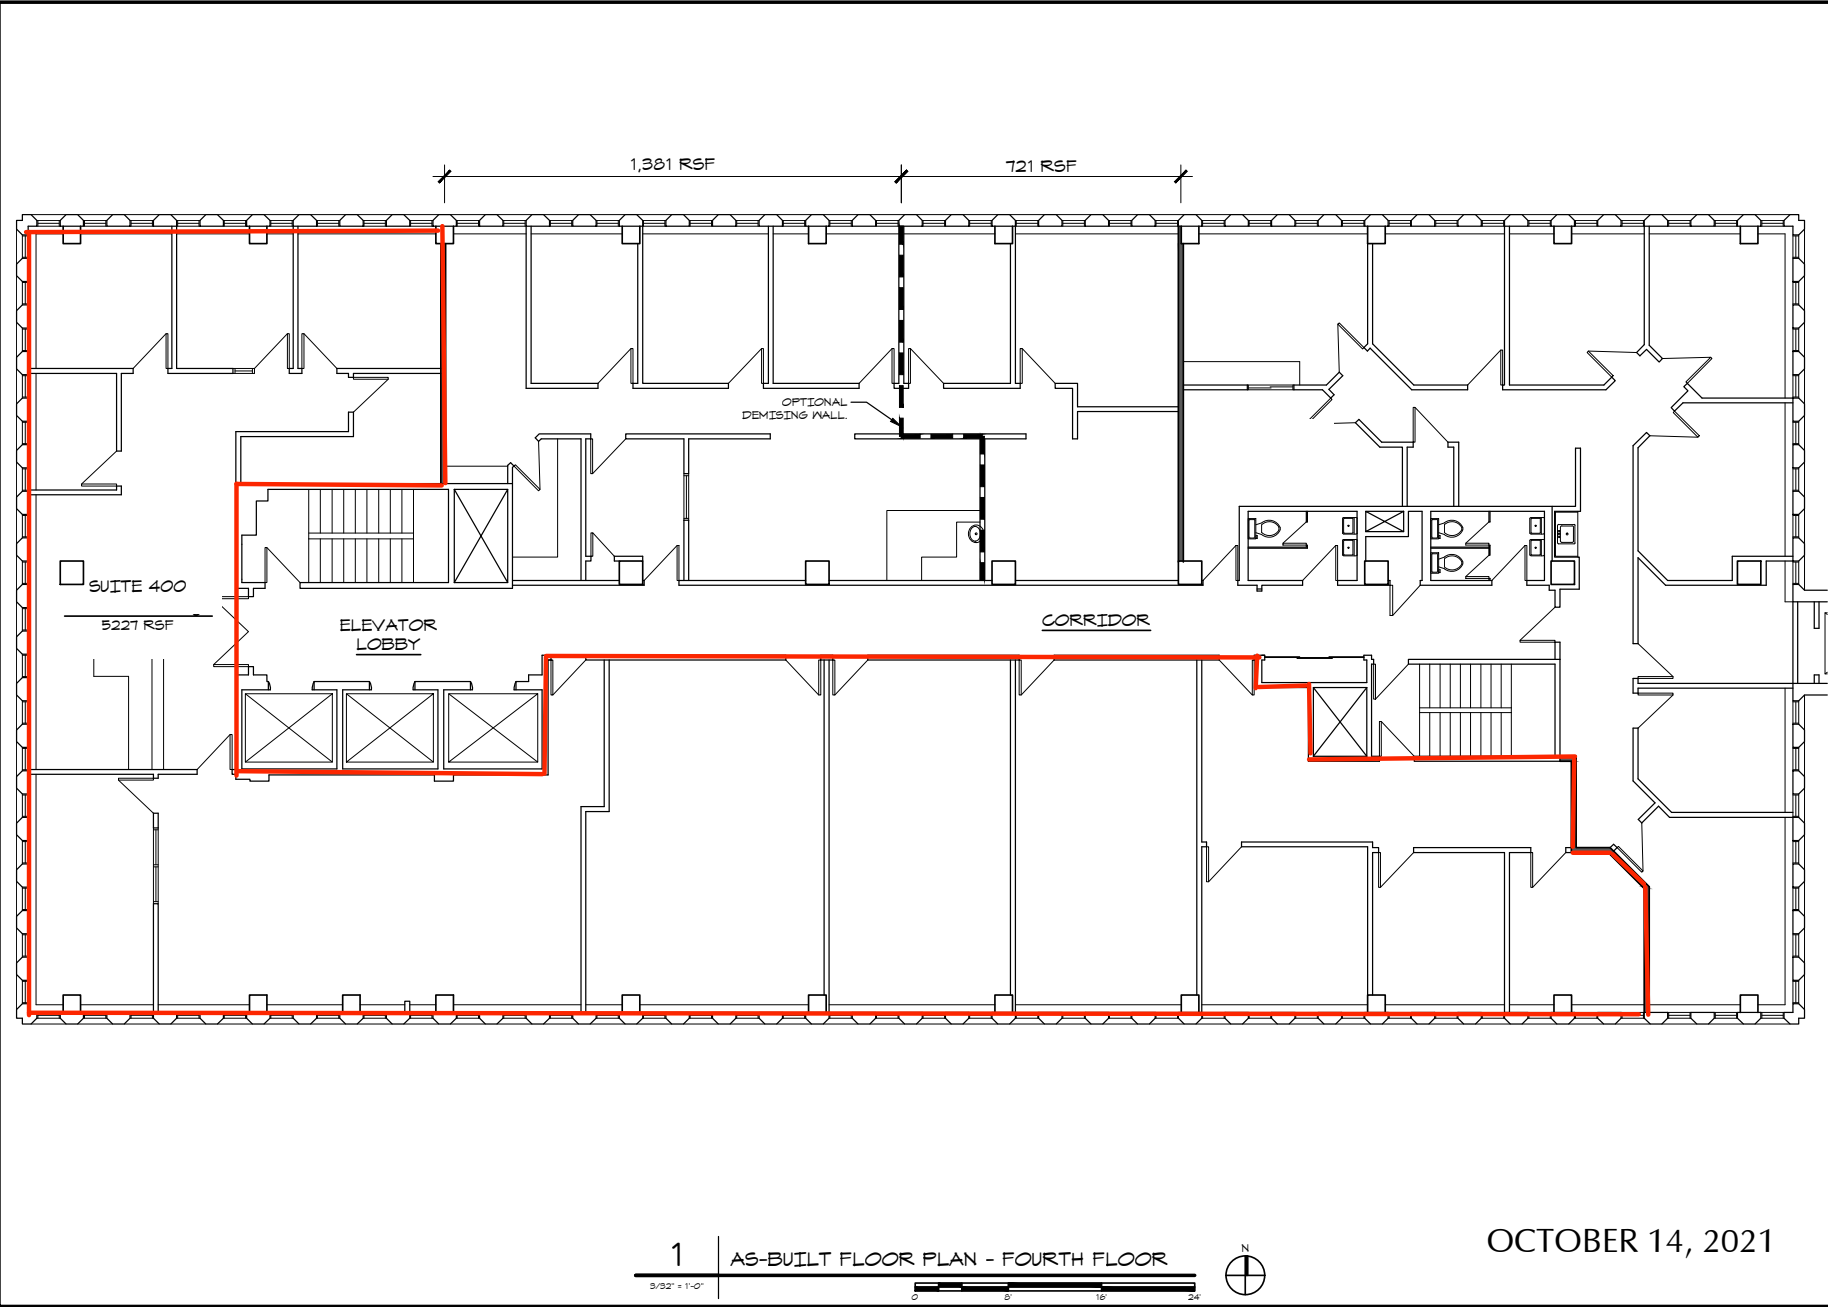

1 AS-BUILT FLOOR PLAN - FOURTH FLOOR  
3/32" = 1'-0"

OCTOBER 14, 2021

ARCHITECT  
**PIPER-WIND ARCHITECTS, Inc.**  
2121 CENTRAL STREET, SUITE 143  
KANSAS CITY, MISSOURI 64108  
TEL: (816) 474-3050  
FAX: (816) 474-3051

**BLUE RIDGE TOWER**  
AS-BUILT FLOOR PLANS  
4240 BLUE RIDGE BOULEVARD, KANSAS CITY, MISSOURI 64133

NOT FOR CONSTRUCTION

PROJECT NO.	03330
DATE	10 / 14 / 2021
DRAWN BY	ADP
CHECKED BY	ADP
CREATED BY	ADP
REVISED DATE	DESCRIPTION

SHEET TITLE & NUMBER  
**FOURTH FLOOR PLAN**

COPYRIGHT © 2021  
PIPER-WIND ARCHITECTS, Inc.

A-104