



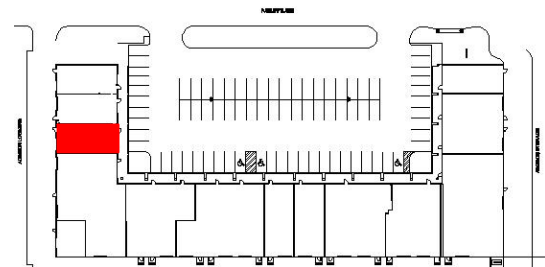

Z PROJECTS, LLC  
1413 JACKSON RD.  
KELLER, TX 76262  
817.876.1806  
[www.linkedin.com/in/davezobrist](http://www.linkedin.com/in/davezobrist)

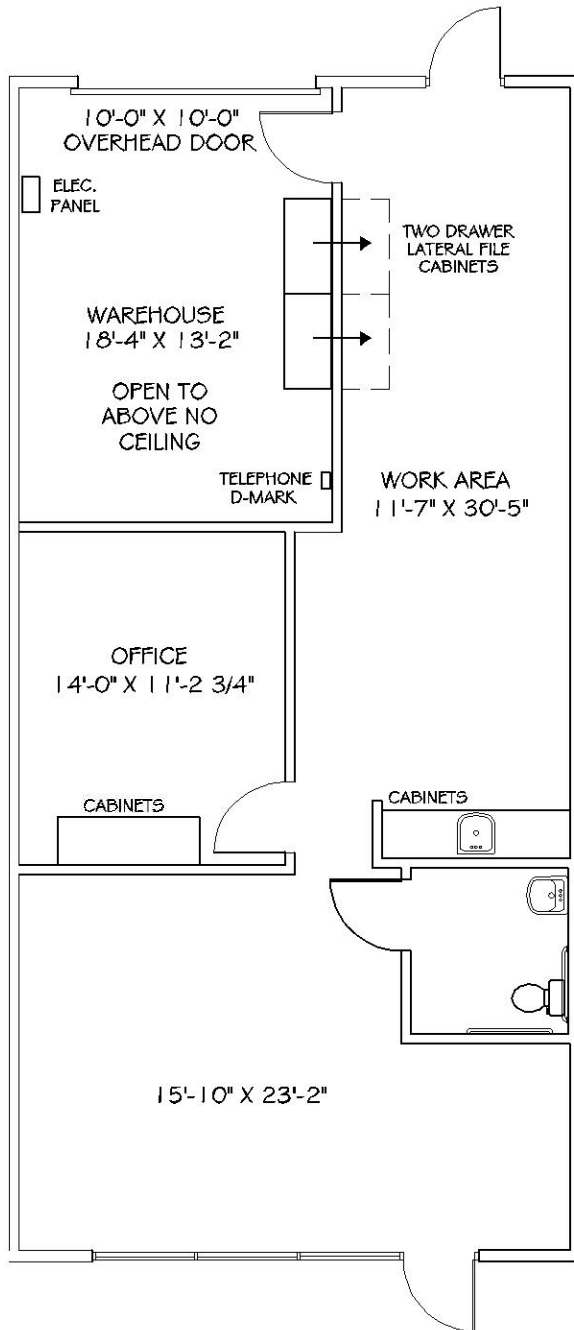

ROBERT B. POWELL, CCIM  
POWELL REALTY ADVISORS, LLC.  
214-908-3488  
[Robert.Powell@PowellRealtyAdvisors.com](mailto:Robert.Powell@PowellRealtyAdvisors.com)

**AIRPORT PLAZA**  
SUITE 117 | 2,000 SF  
4500 RATLIFF | ADDISON, TX 75001

**AS BUILT**

11.05.2025