
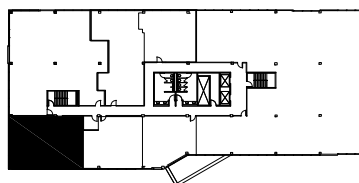


# GRAYMARK OFFICE BUILDING

16801 Addison Rd., Addison, Texas

SUITE 430  
1,524 RSF

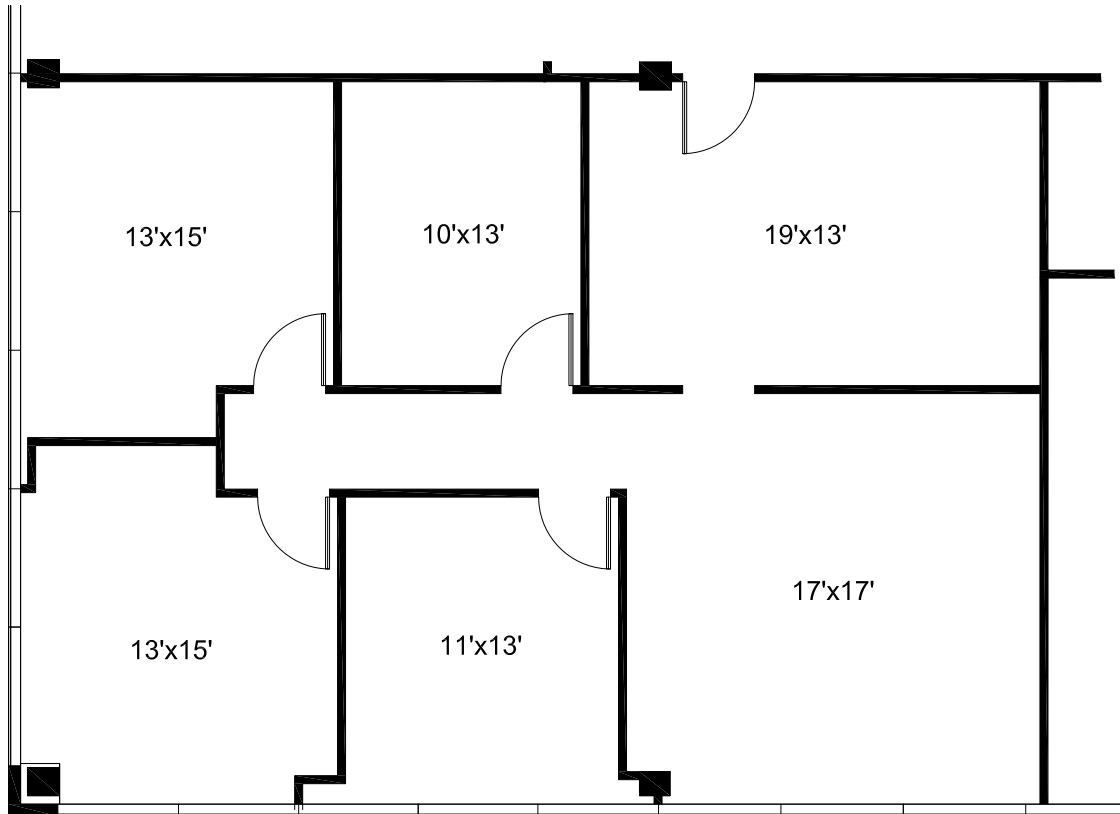

4TH FLOOR

Scale: 1/8"=1'-0"

All dimensions and square footages are approximate.

December 30, 2025