



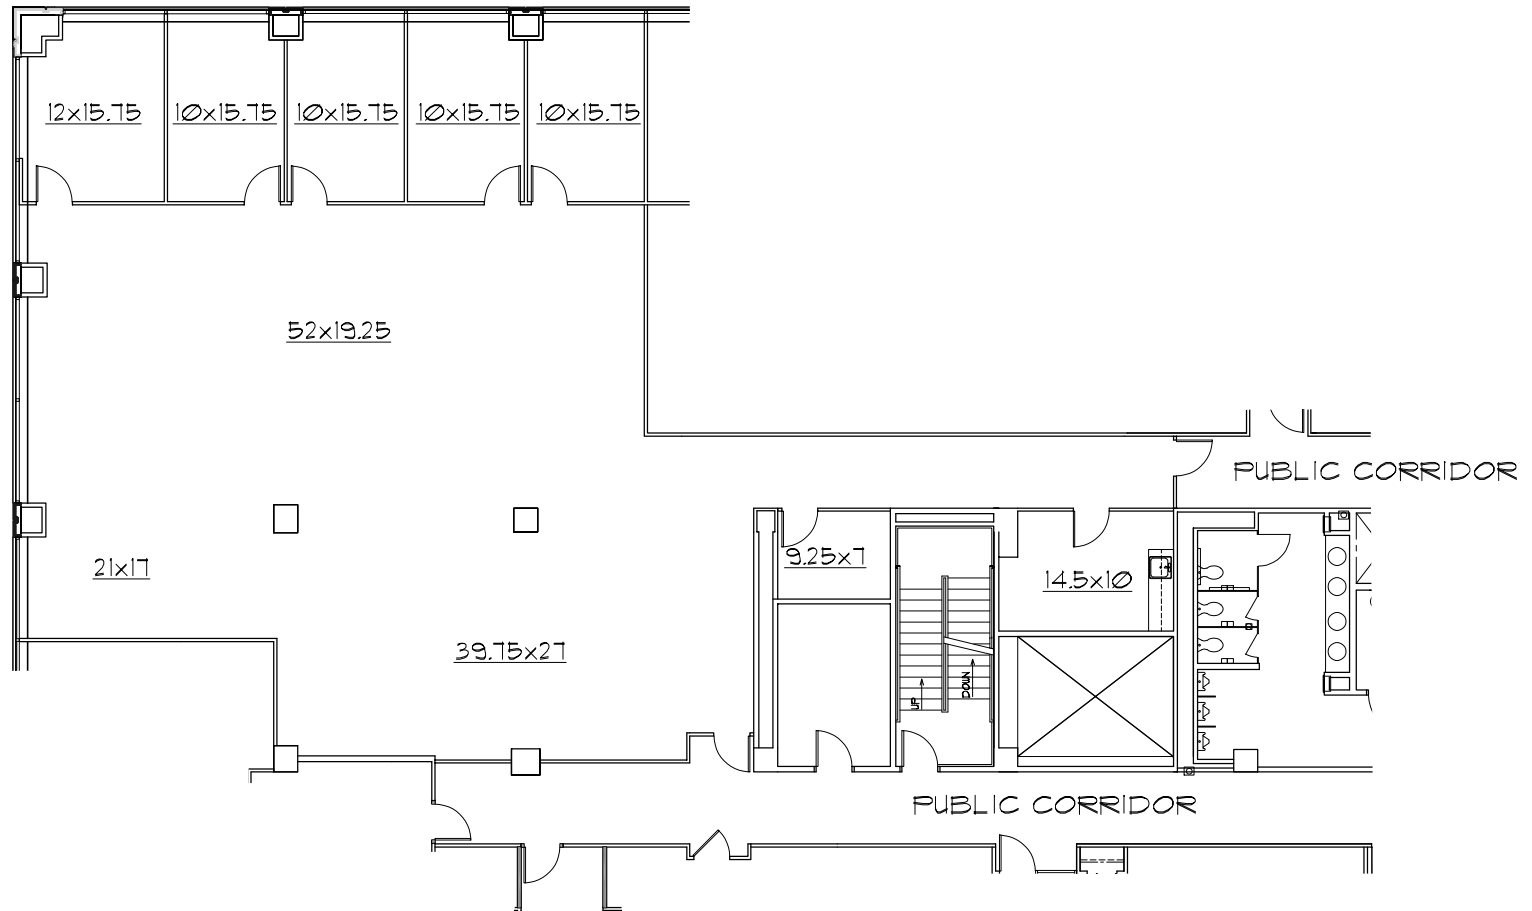

VARADY ASSOCIATES INC.

INTERIOR DESIGN

30400 TELEGRAPH RD., SUITE 120
BINGHAM FARMS, MI 48025
248-644-3990

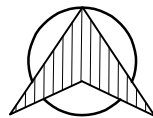

NORTH

AS-BUILT PLAN

OAKLAND COMMONS II - SUITE 430

20750 CIVIC CENTER DRIVE

SOUTHFIELD, MICHIGAN 48076

4,254 RENTABLE SF

SCALE: 1/8" = 1'-0"

**Farbman
Group**
FULL SERVICE REAL ESTATE SOLUTIONS

NAL Farbman
COMMERCIAL REAL ESTATE SERVICES, WORLDWIDE

CONTACT: LESLEY GUTMAN
(248) 351-4383 LGUTMAN@FARBMAN.COM