


FIRST FLOOR PLAN  
Ceiling Height = See Drawing



Scale 1/16" = 1'-0"

<b>EXISTING CONDITIONS PLANS</b>		
JOB NO.	DATE: JUNE 2024	SCALE: 1/16" = 1'-0"
<b>NATIONAL FLOOR PLANS</b> 398 COLUMBUS AVENUE SUITE 100 BOSTON MA 02116 800.328.0217 TEL		<b>1200 OAKLAWN AVENUE</b> <b>CRANSTON, RI</b>
		<b>1</b>

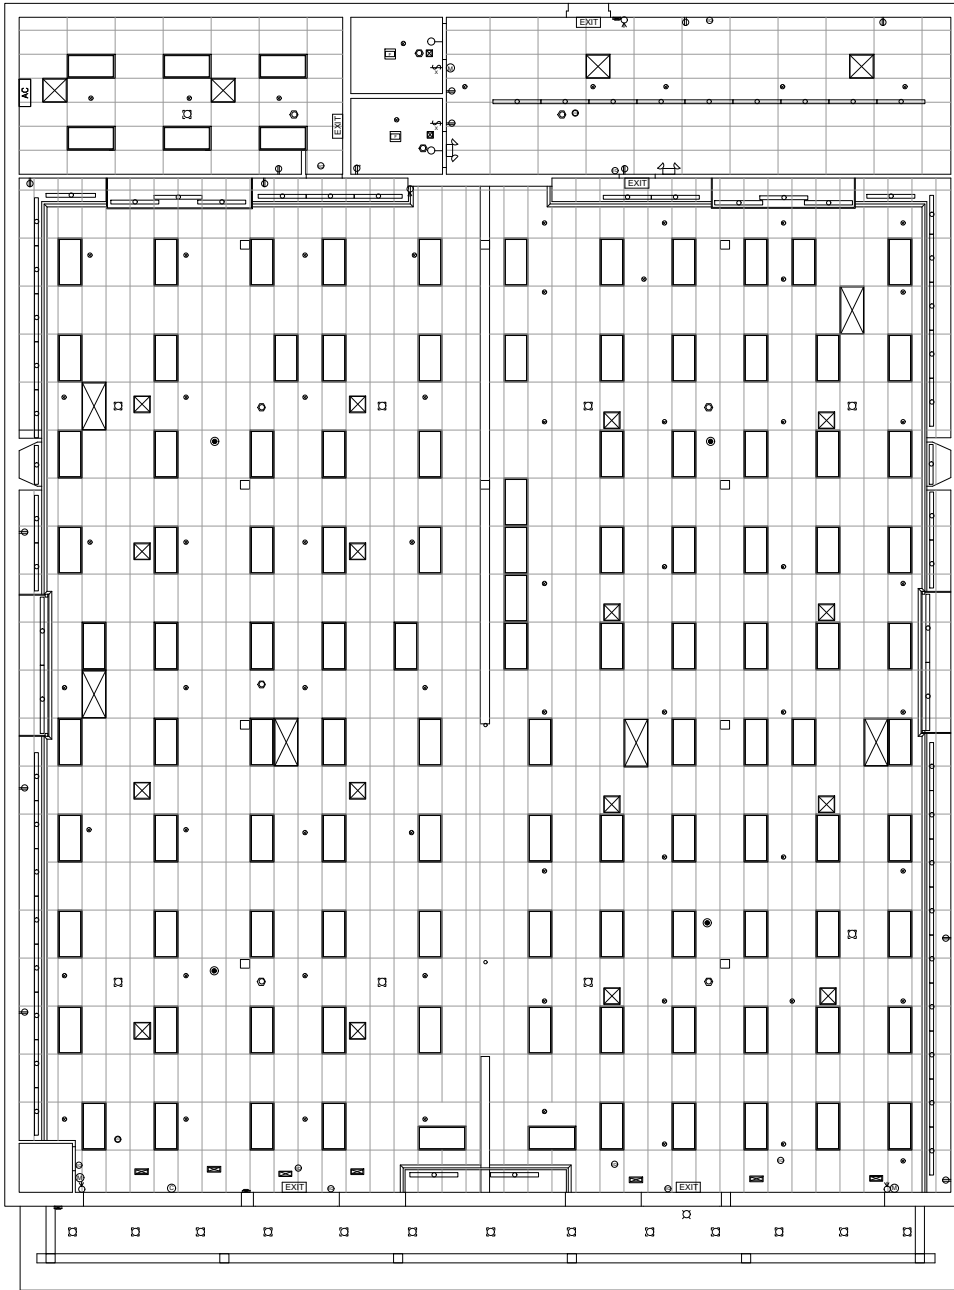

**SYMBOL LEGEND LIST**

	SWITCH
	2x4x8 LIGHT FIXTURE
	FLUORESCENT LIGHT
	SMOKE DETECTOR
	SPRINKLER
	FIRE EXTINGUISHER
	FIRE ALARM STROBE
	EMERGENCY LIGHT W/O EXIT
	SECURITY CAMERA
	RECESSED LIGHT FIXTURE
	DUPLEX OUTLET
	GFCI OUTLET
	WALL MOUNTED FIXTURE
	FIRE ALARM
	AIR CONDITIONER
	SPEAKER
	EQUIPMENT- MISC.
	MOTION DETECTOR
	HANGING FIXTURE
	EXHAUST FAN W/ LIGHT
	EXIT SIGN
	VENT

FIRST FLOOR RCP PLAN  
Ceiling Height = See Drawing



1' 2' 4' 8'

Scale 1/16" = 1'-0"

<b>EXISTING CONDITIONS PLANS</b>			<b>2</b>
JOB NO.	DATE: JUNE 2024	SCALE: 1/16" = 1'-0"	
<b>NATIONAL FLOOR PLANS</b>		<b>1200 OAKLAWN AVENUE</b>	
398 COLUMBUS AVENUE SUITE 100 BOSTON MA 02116 800.328.0217 TEL		CRANSTON, RI	