


SUITE 100

As Built Floor Plan

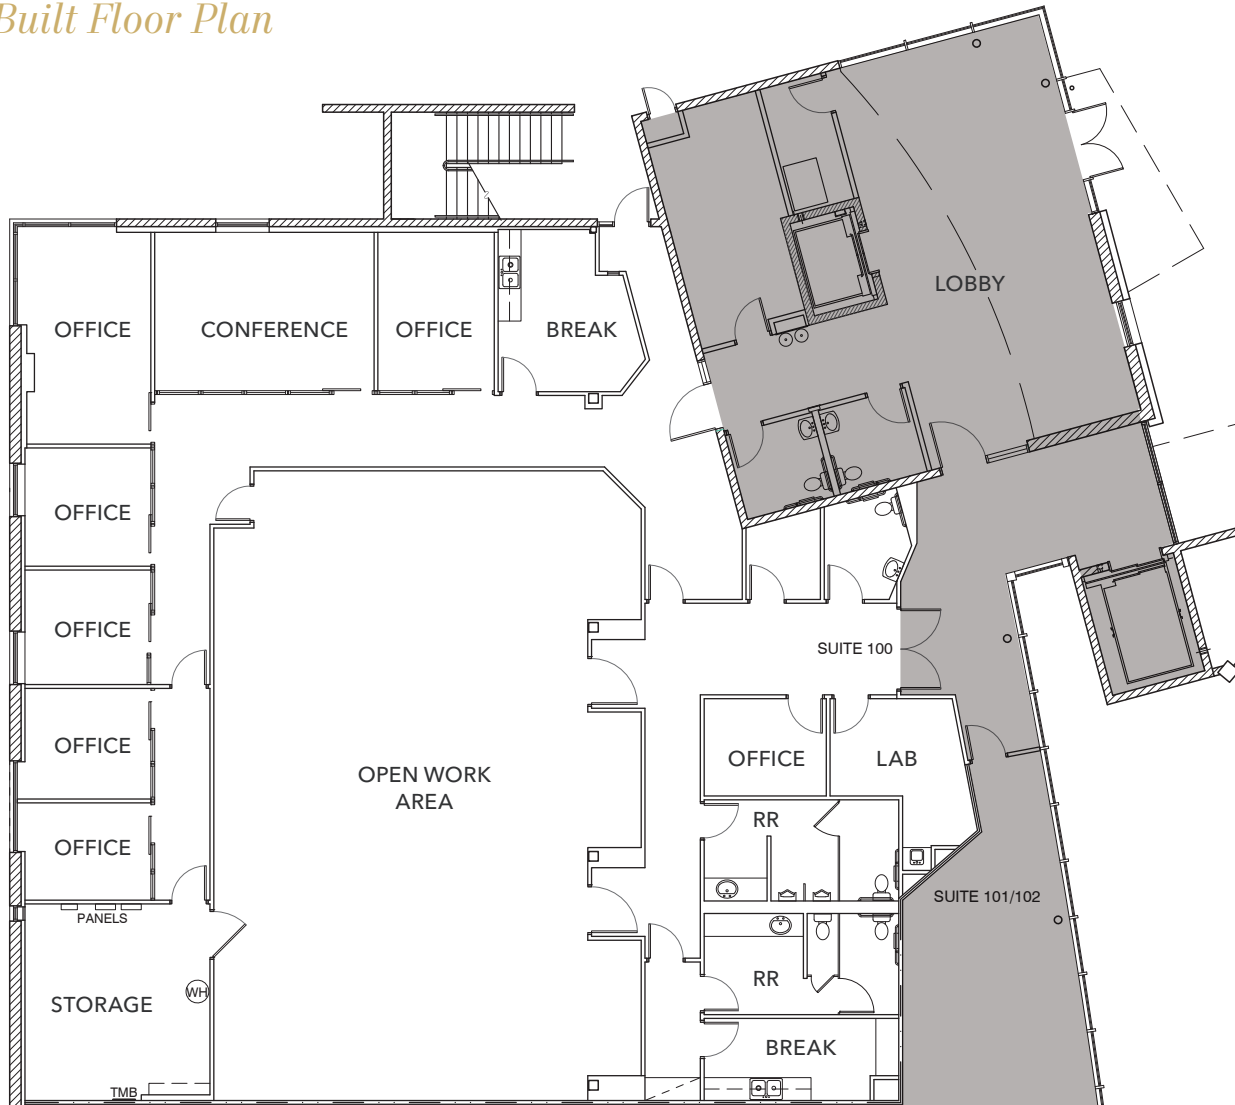

AVAILABLE FOR LEASE

±6,209 SF

AVAILABLE

Leasing by

PERRY GABUZZI, CCIM
602.513.5116
perry.gabuzzi@kidder.com

RACHAEL THOMPSON
602.513.5122
rachael.thompson@kidder.com



Owned by



SUITE 100

Test Fit Floor Plan



±6,209 SF

AVAILABLE

Leasing by

PERRY GABUZZI, CCIM
602.513.5116
perry.gabuzzi@kiddermathews.com

RACHAEL THOMPSON
602.513.5122
rachael.thompson@kiddermathews.com




Owned by



FIRST FLOOR

Test Fit Demising Floor Plan

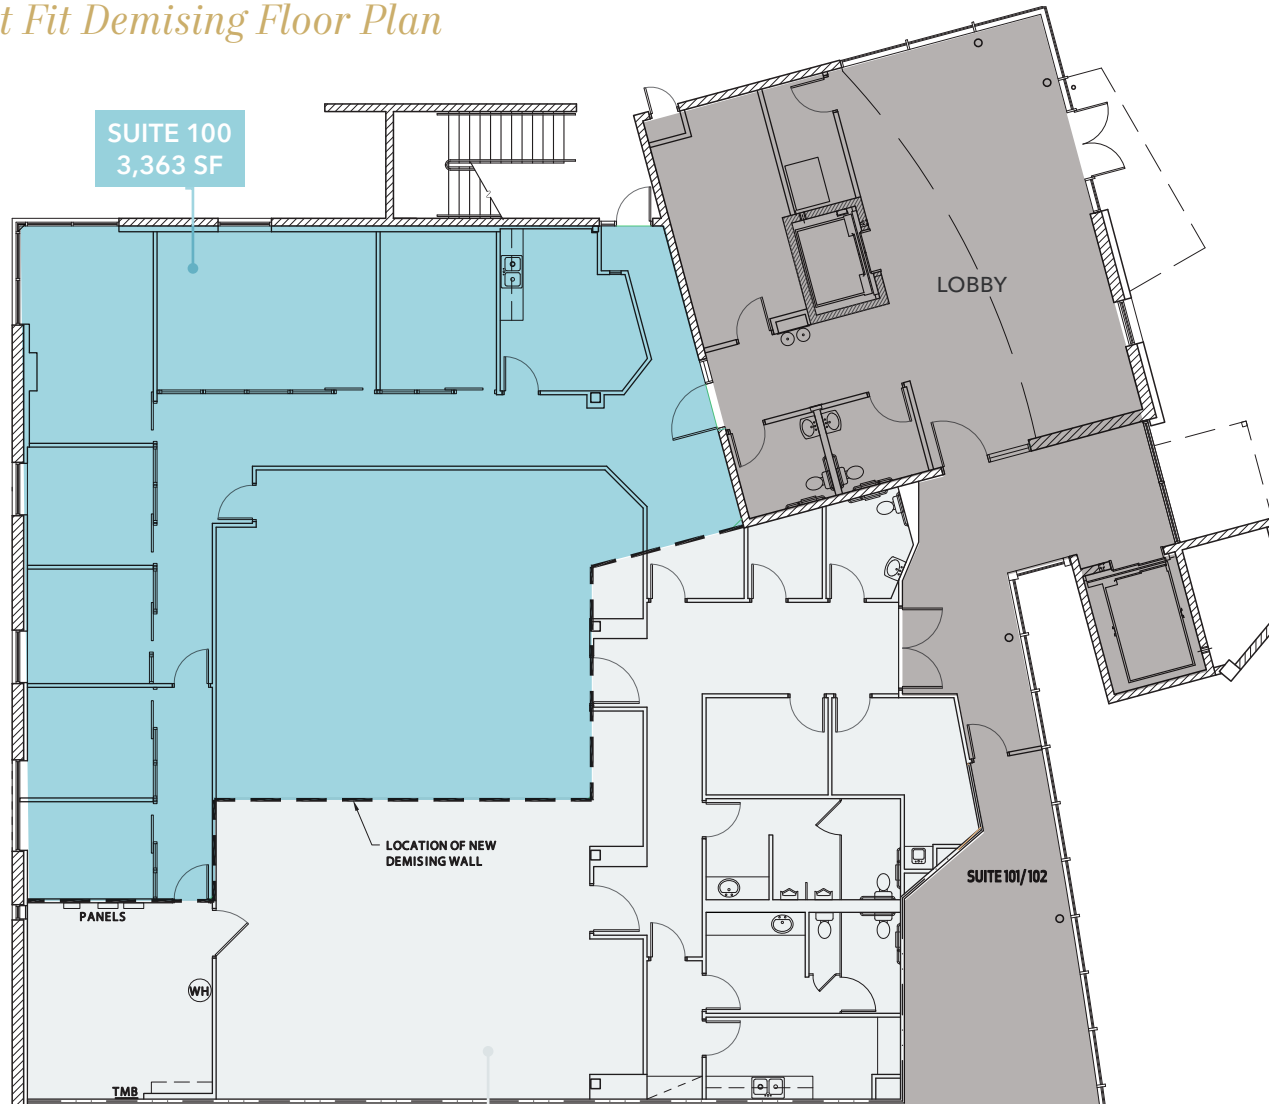

SUITE 100
3,363 SF

LOCATION OF NEW
DEMISING WALL

LOBBY

SUITE 101/102

SUITE 103
2,846 SF

AVAILABLE FOR LEASE

±6,209 SF

AVAILABLE

Leasing by

PERRY GABUZZI, CCIM
602.513.5116
perry.gabuzzi@kidder.com

RACHAEL THOMPSON
602.513.5122
rachael.thompson@kidder.com

km Kidder Mathews

Owned by

CADDIS
HEALTHCARE REAL ESTATE