

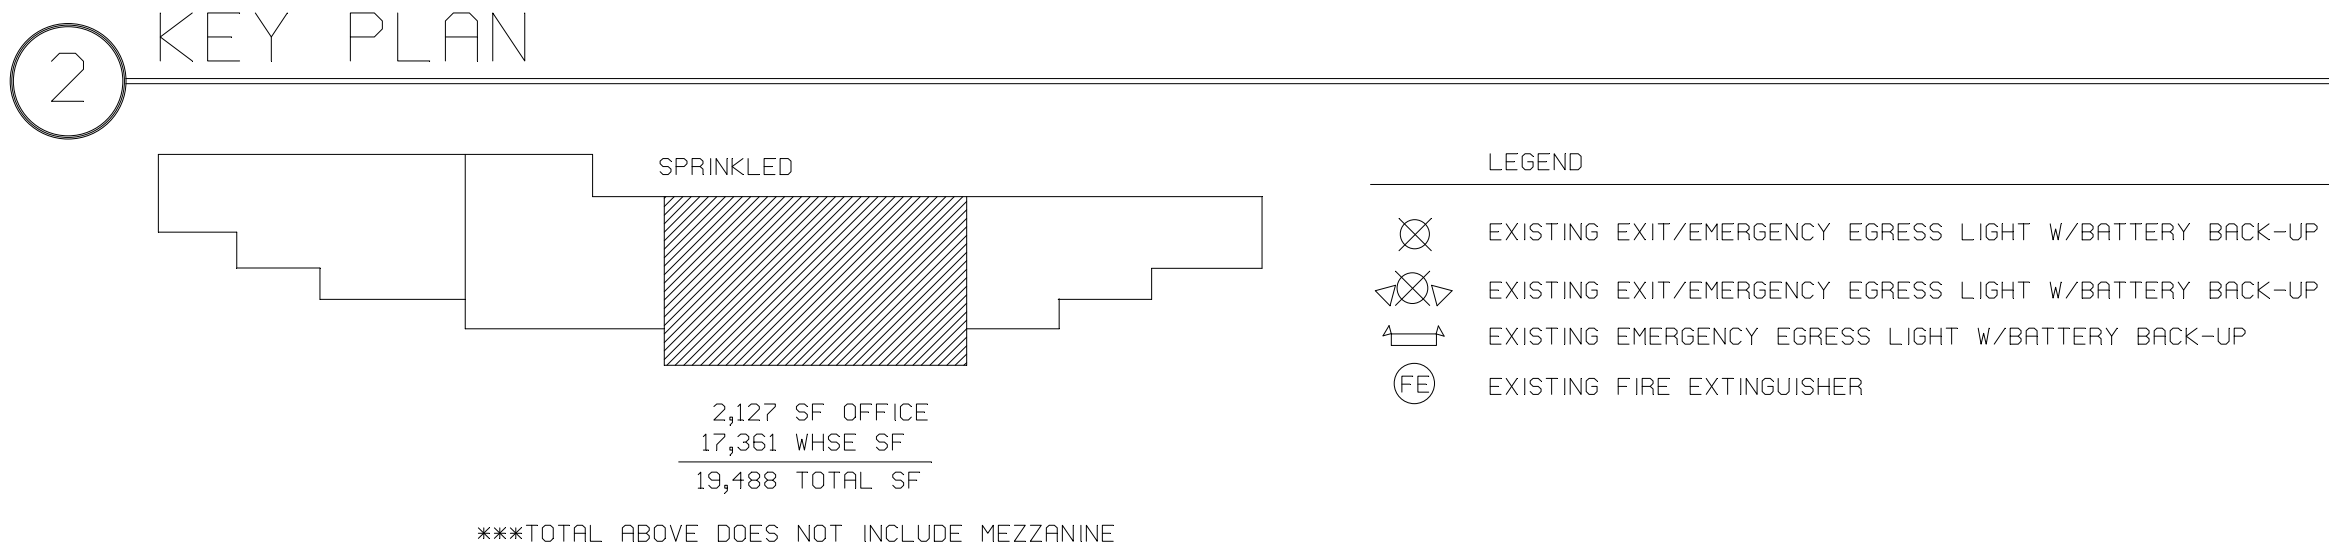


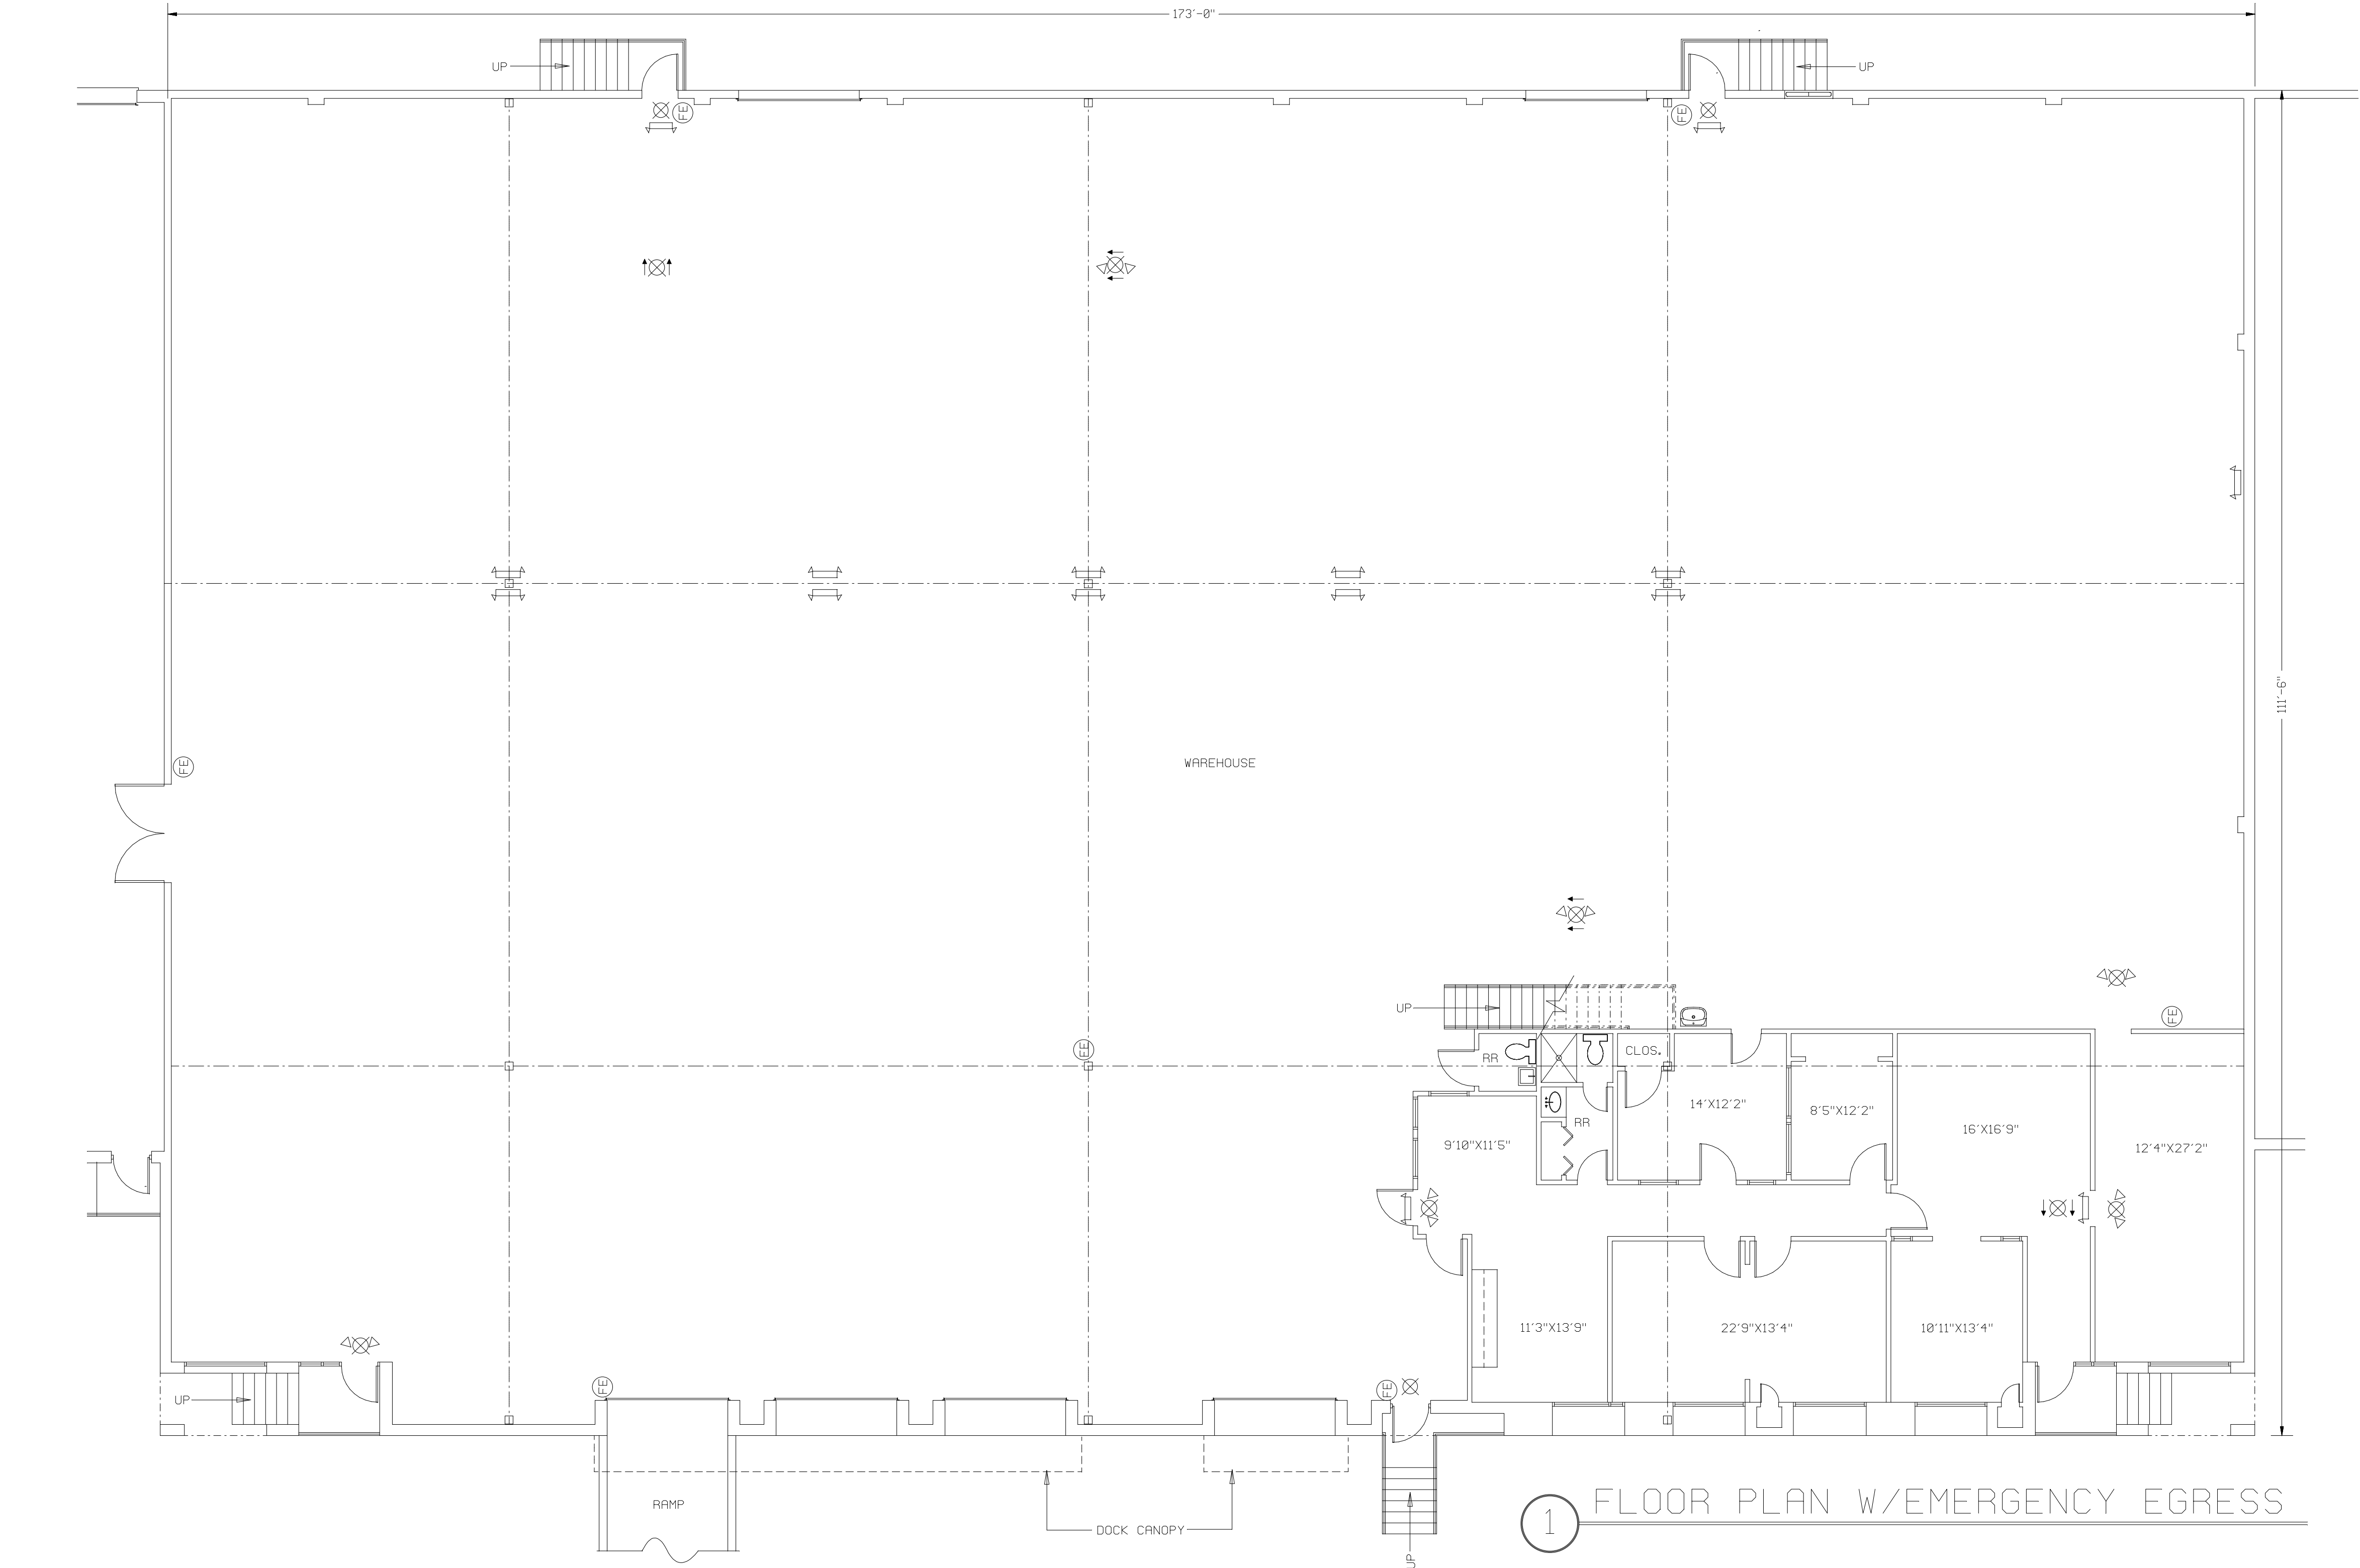

1 FLOOR PLAN W/EMERGENCY EGRESS

3 MEZZANINE PLAN

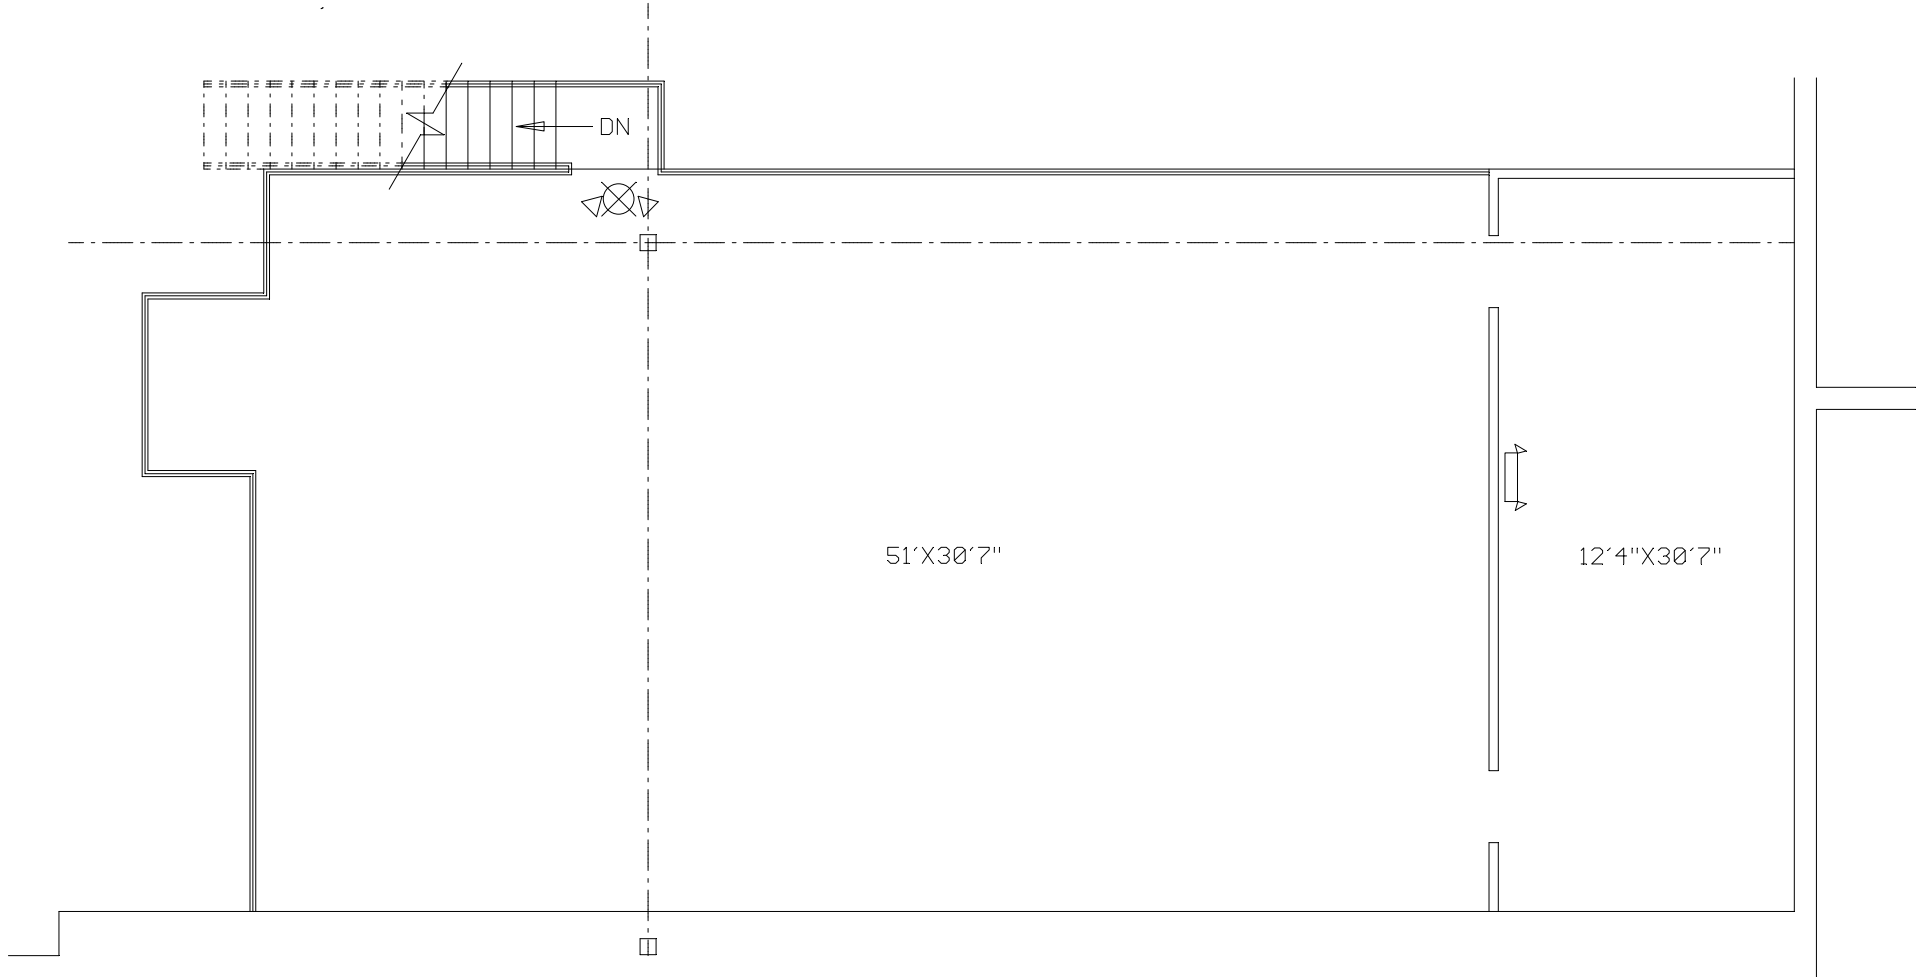

coyle-thompson-jones, llc.

4191 PLEASANTDALE ROAD
ATLANTA, GEORGIA 30340

AS-BUILT FOR:

ID-1
OF 1

CONTACT INFORMATION:		DRAWN BY: LMPDNEILL		REVISIONS	
E-MAIL: cthompson@ctjdesigns.com		DATE: MAY 13, 2022			
WEBSITE: www.ctjdesigns.com		SCALE: 1/8" = 1'-0"			
				SQUARE FOOTAGE:	

PHONE: (678) 638-6252

ONE GLENLAKE PARKWAY, SUITE 650, ATLANTA, GA 30328