


SPACE AVAILABLE

SUITE 200: 4,117 RSF

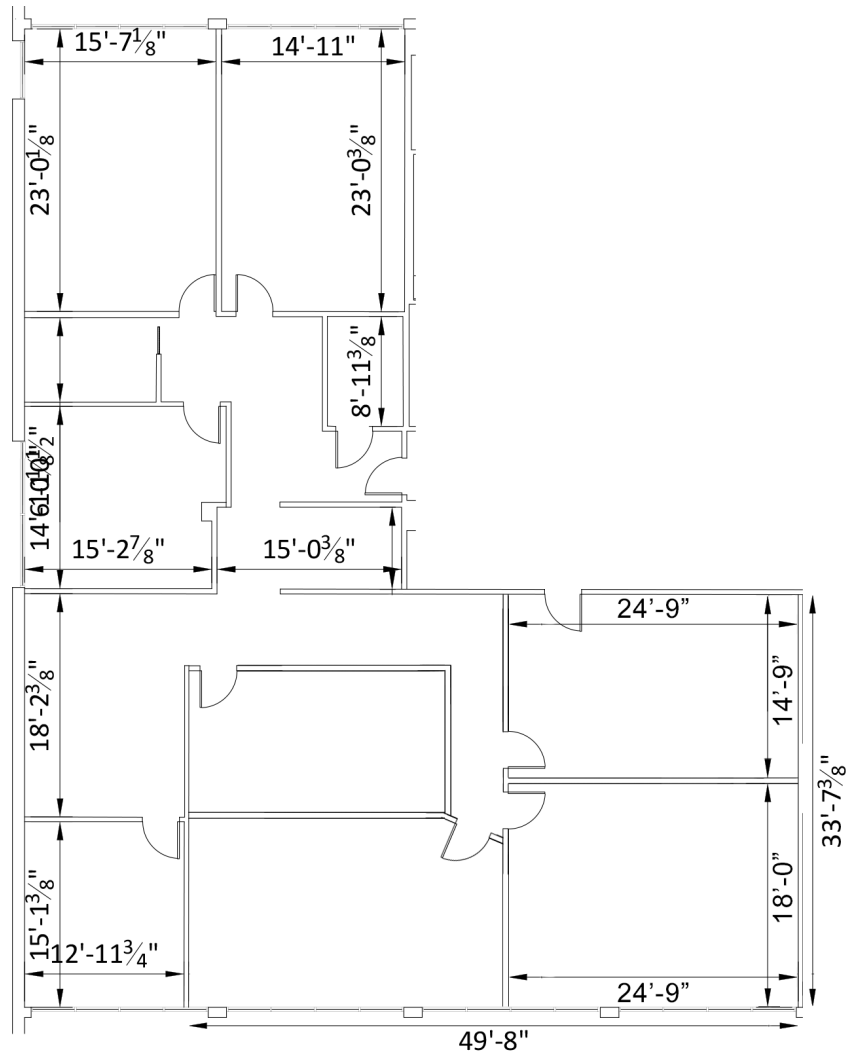

WESTSHORE CITY CENTER
1111 N. Westshore Blvd
Tampa, FL 33607

No warranty or representation, expressed or implied, is made to the accuracy of information contained herein, and same is submitted subject to errors, change of price, rental or other conditions, withdrawal without notice, and to any special listing conditions imposed by our principals. PLANS NOT TO SCALE

MATT ALEXANDER
813.559.2006
Matthew.Alexander@FranklinSt.com

LORENZO GONZALEZ
813.793.8421
Lorenzo.Gonzalez@FranklinSt.com

FranklinStreet
Licensed Real Estate Broker | FranklinSt.com