
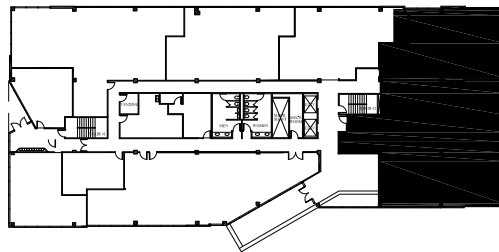


# GRAYMARK OFFICE BUILDING

16801 Addison Road, Addison, Texas

SUITE 100  
5,067 RSF

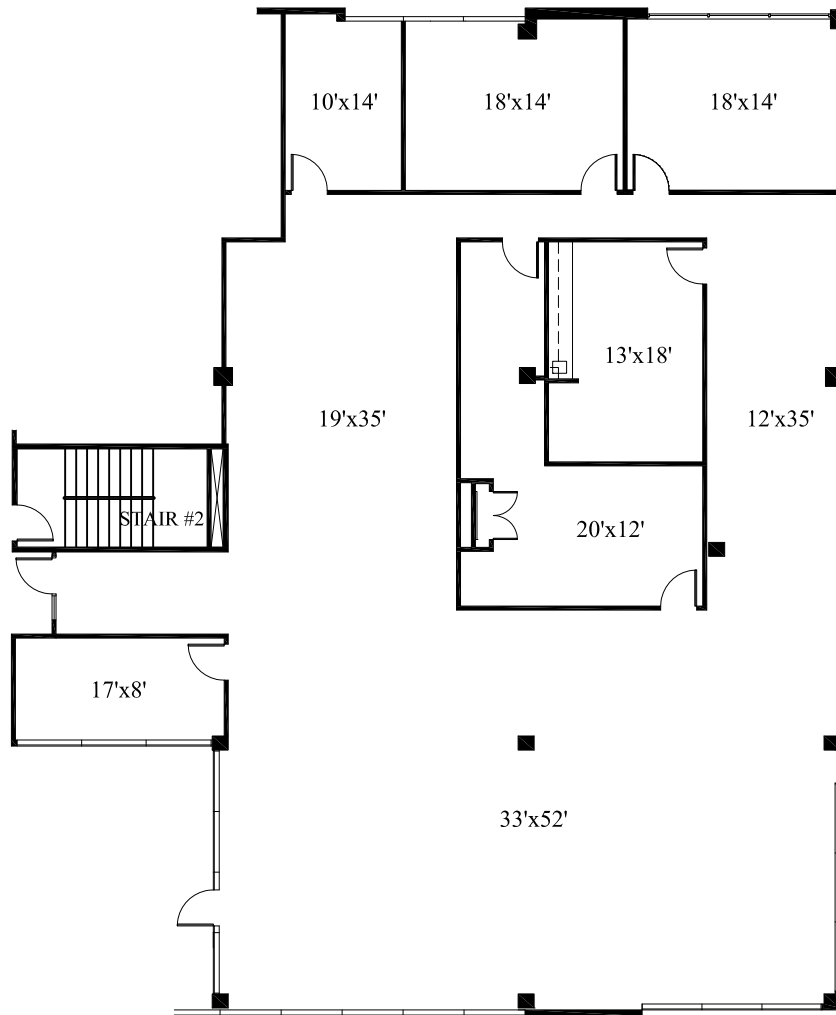

## 1ST FLOOR

Scale: 1/16"=1'-0"

All dimensions and square footages are approximate.

January 11, 2024



THOMPSON CONSULTING SERVICES, INC.

12024 Golden Meadow Lane, Forney, Texas 75126 (972)564-5252