


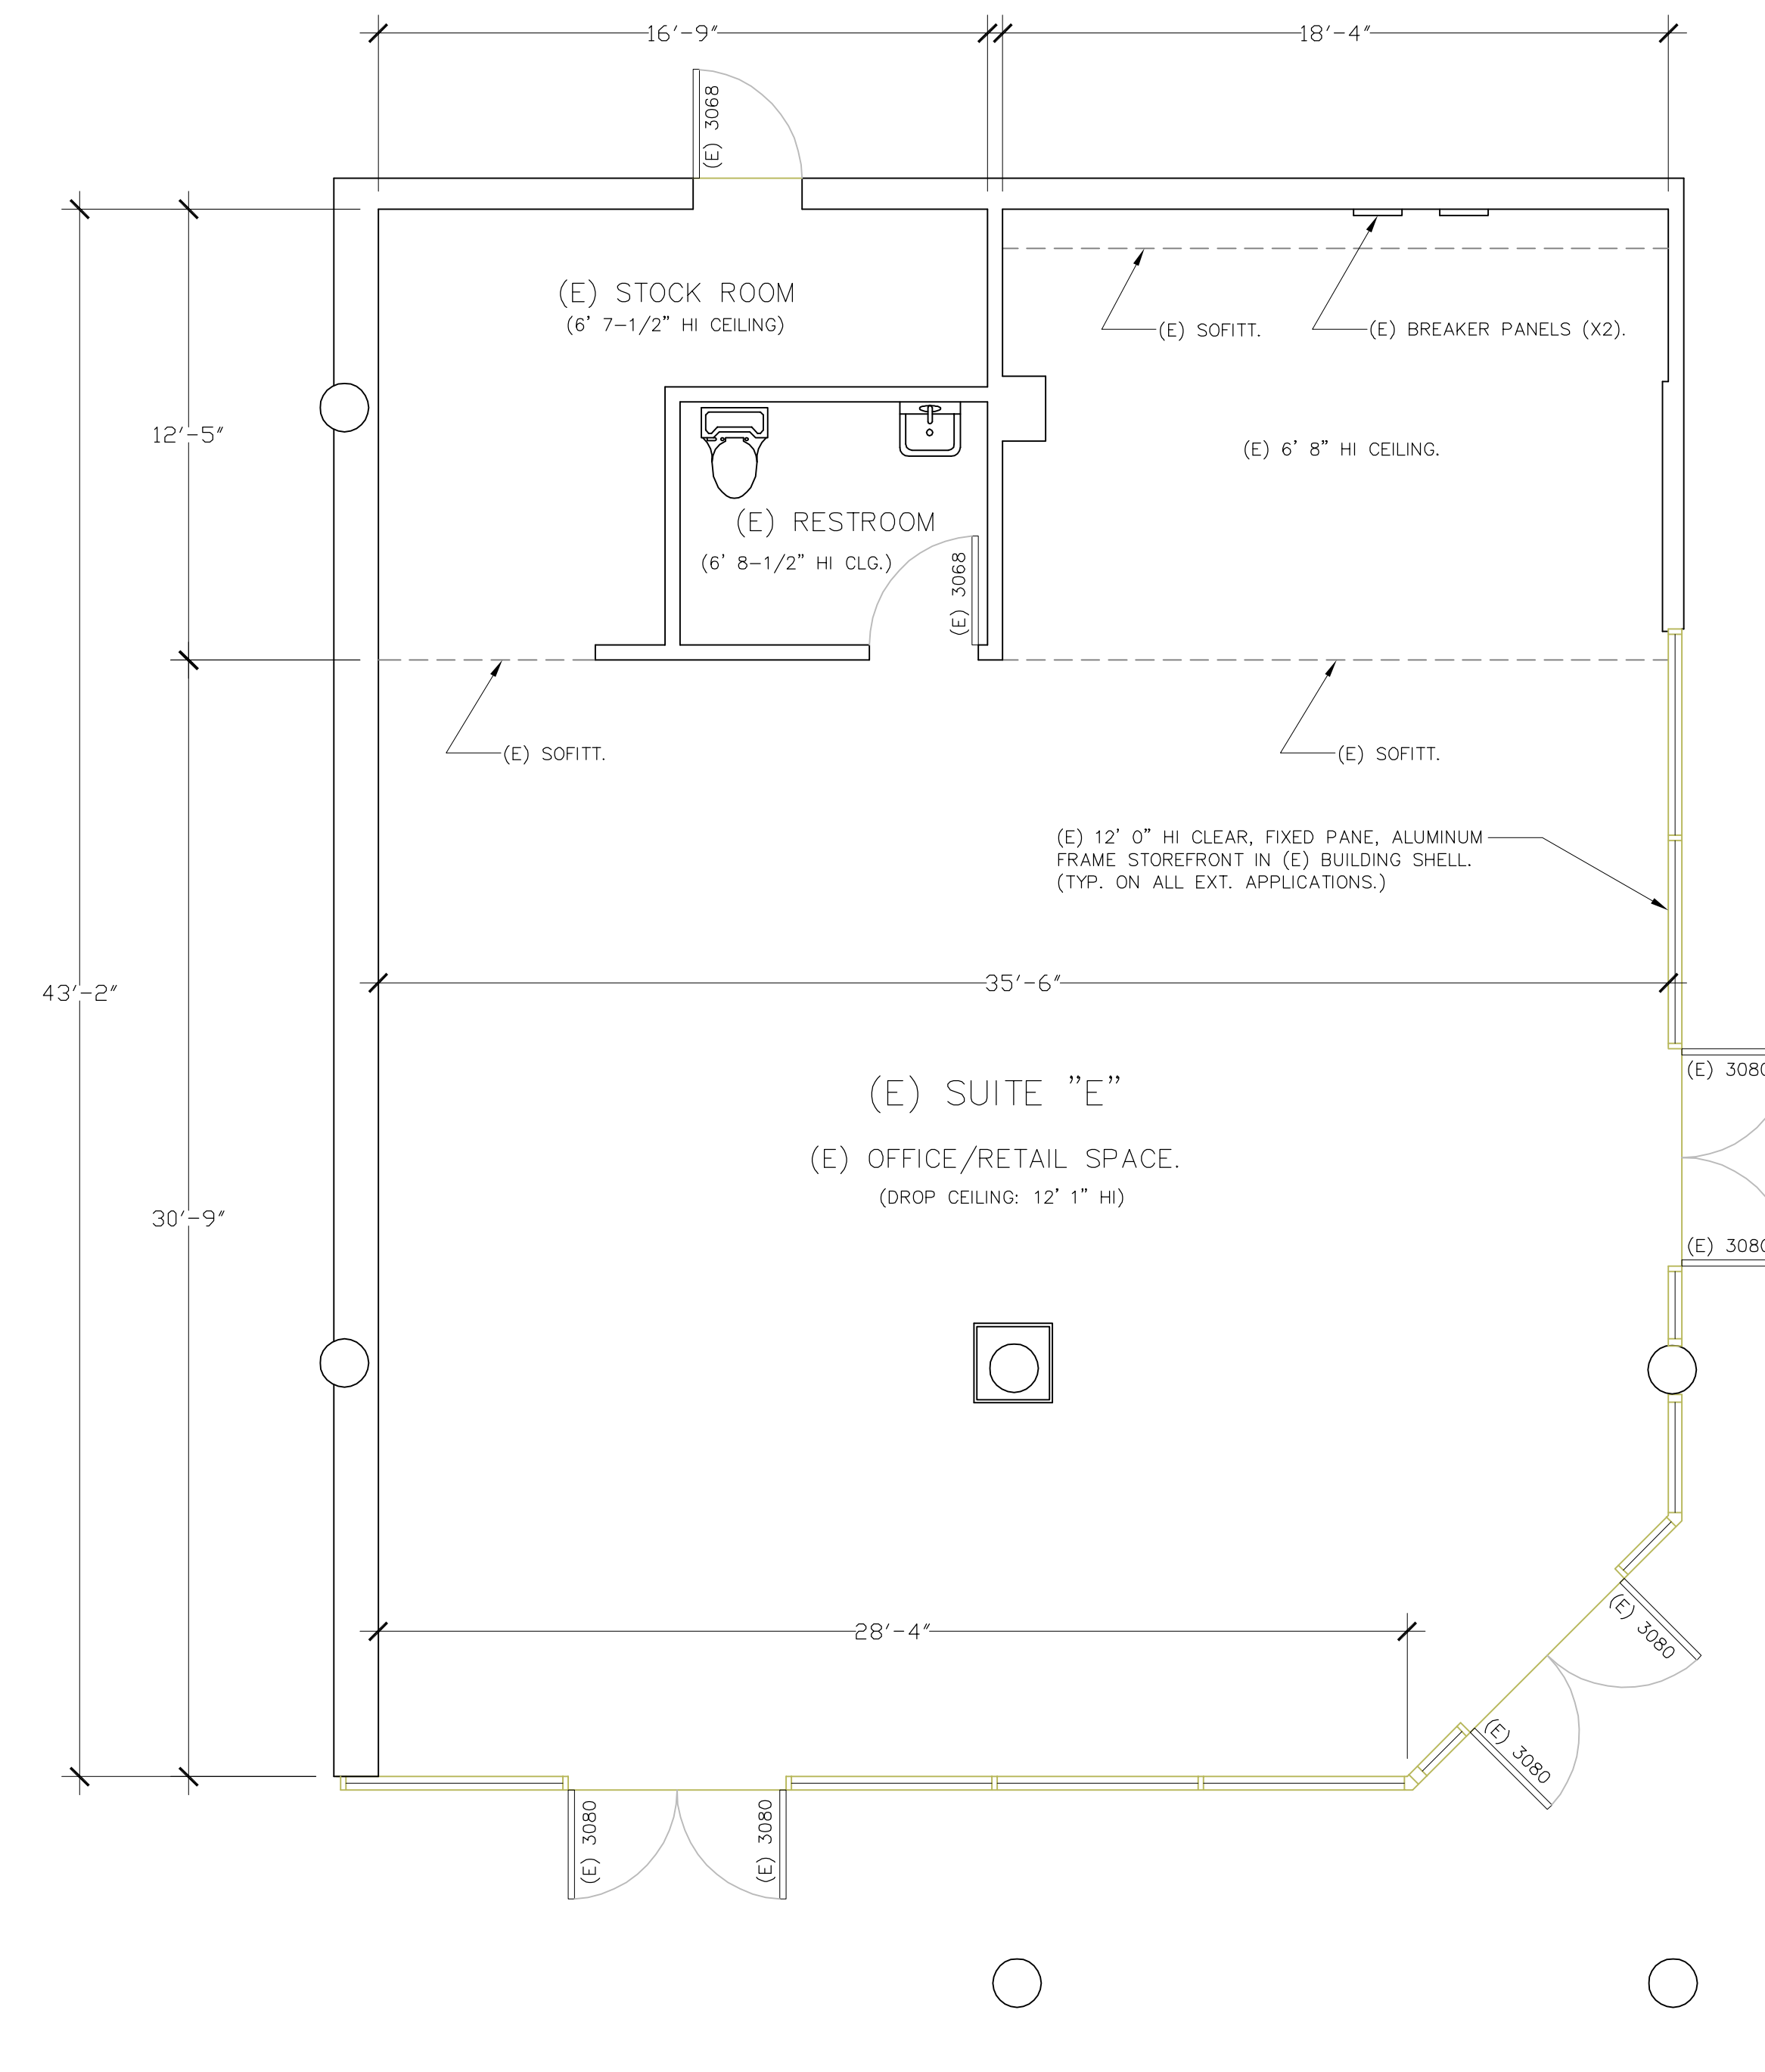

(E) 1ST FLOOR PLAN: SUITE 'E' (1,594 SF)
(401 N. COAST HIGHWAY, OCEANSIDE CA 92054)