


REVISION	DATE	BY	CHKD	DESCRIPTION
1	6-2-2018	MB	DT	100% CONSTRUCTION DOCUMENTS
2	11-12-2018	MB	DT	Addendum #3 (patient station clearances)

OWNER/CLIENT: **Knickerbocker Dialysis, Inc.**
 DaVita Healthcare Partners, Inc.
 2000 16th Street
 Denver, CO 80202

PROJECT: **DaVita Dialysis Half Moon (Project No. 11009)**
 Ramapo Plaza - 1633 Route 202
 Pomona, NY 10970

SHEET TITLE: **RESTRICTIONS PLAN**


PROJECT # 2016157
G-102
 SHEET NO.

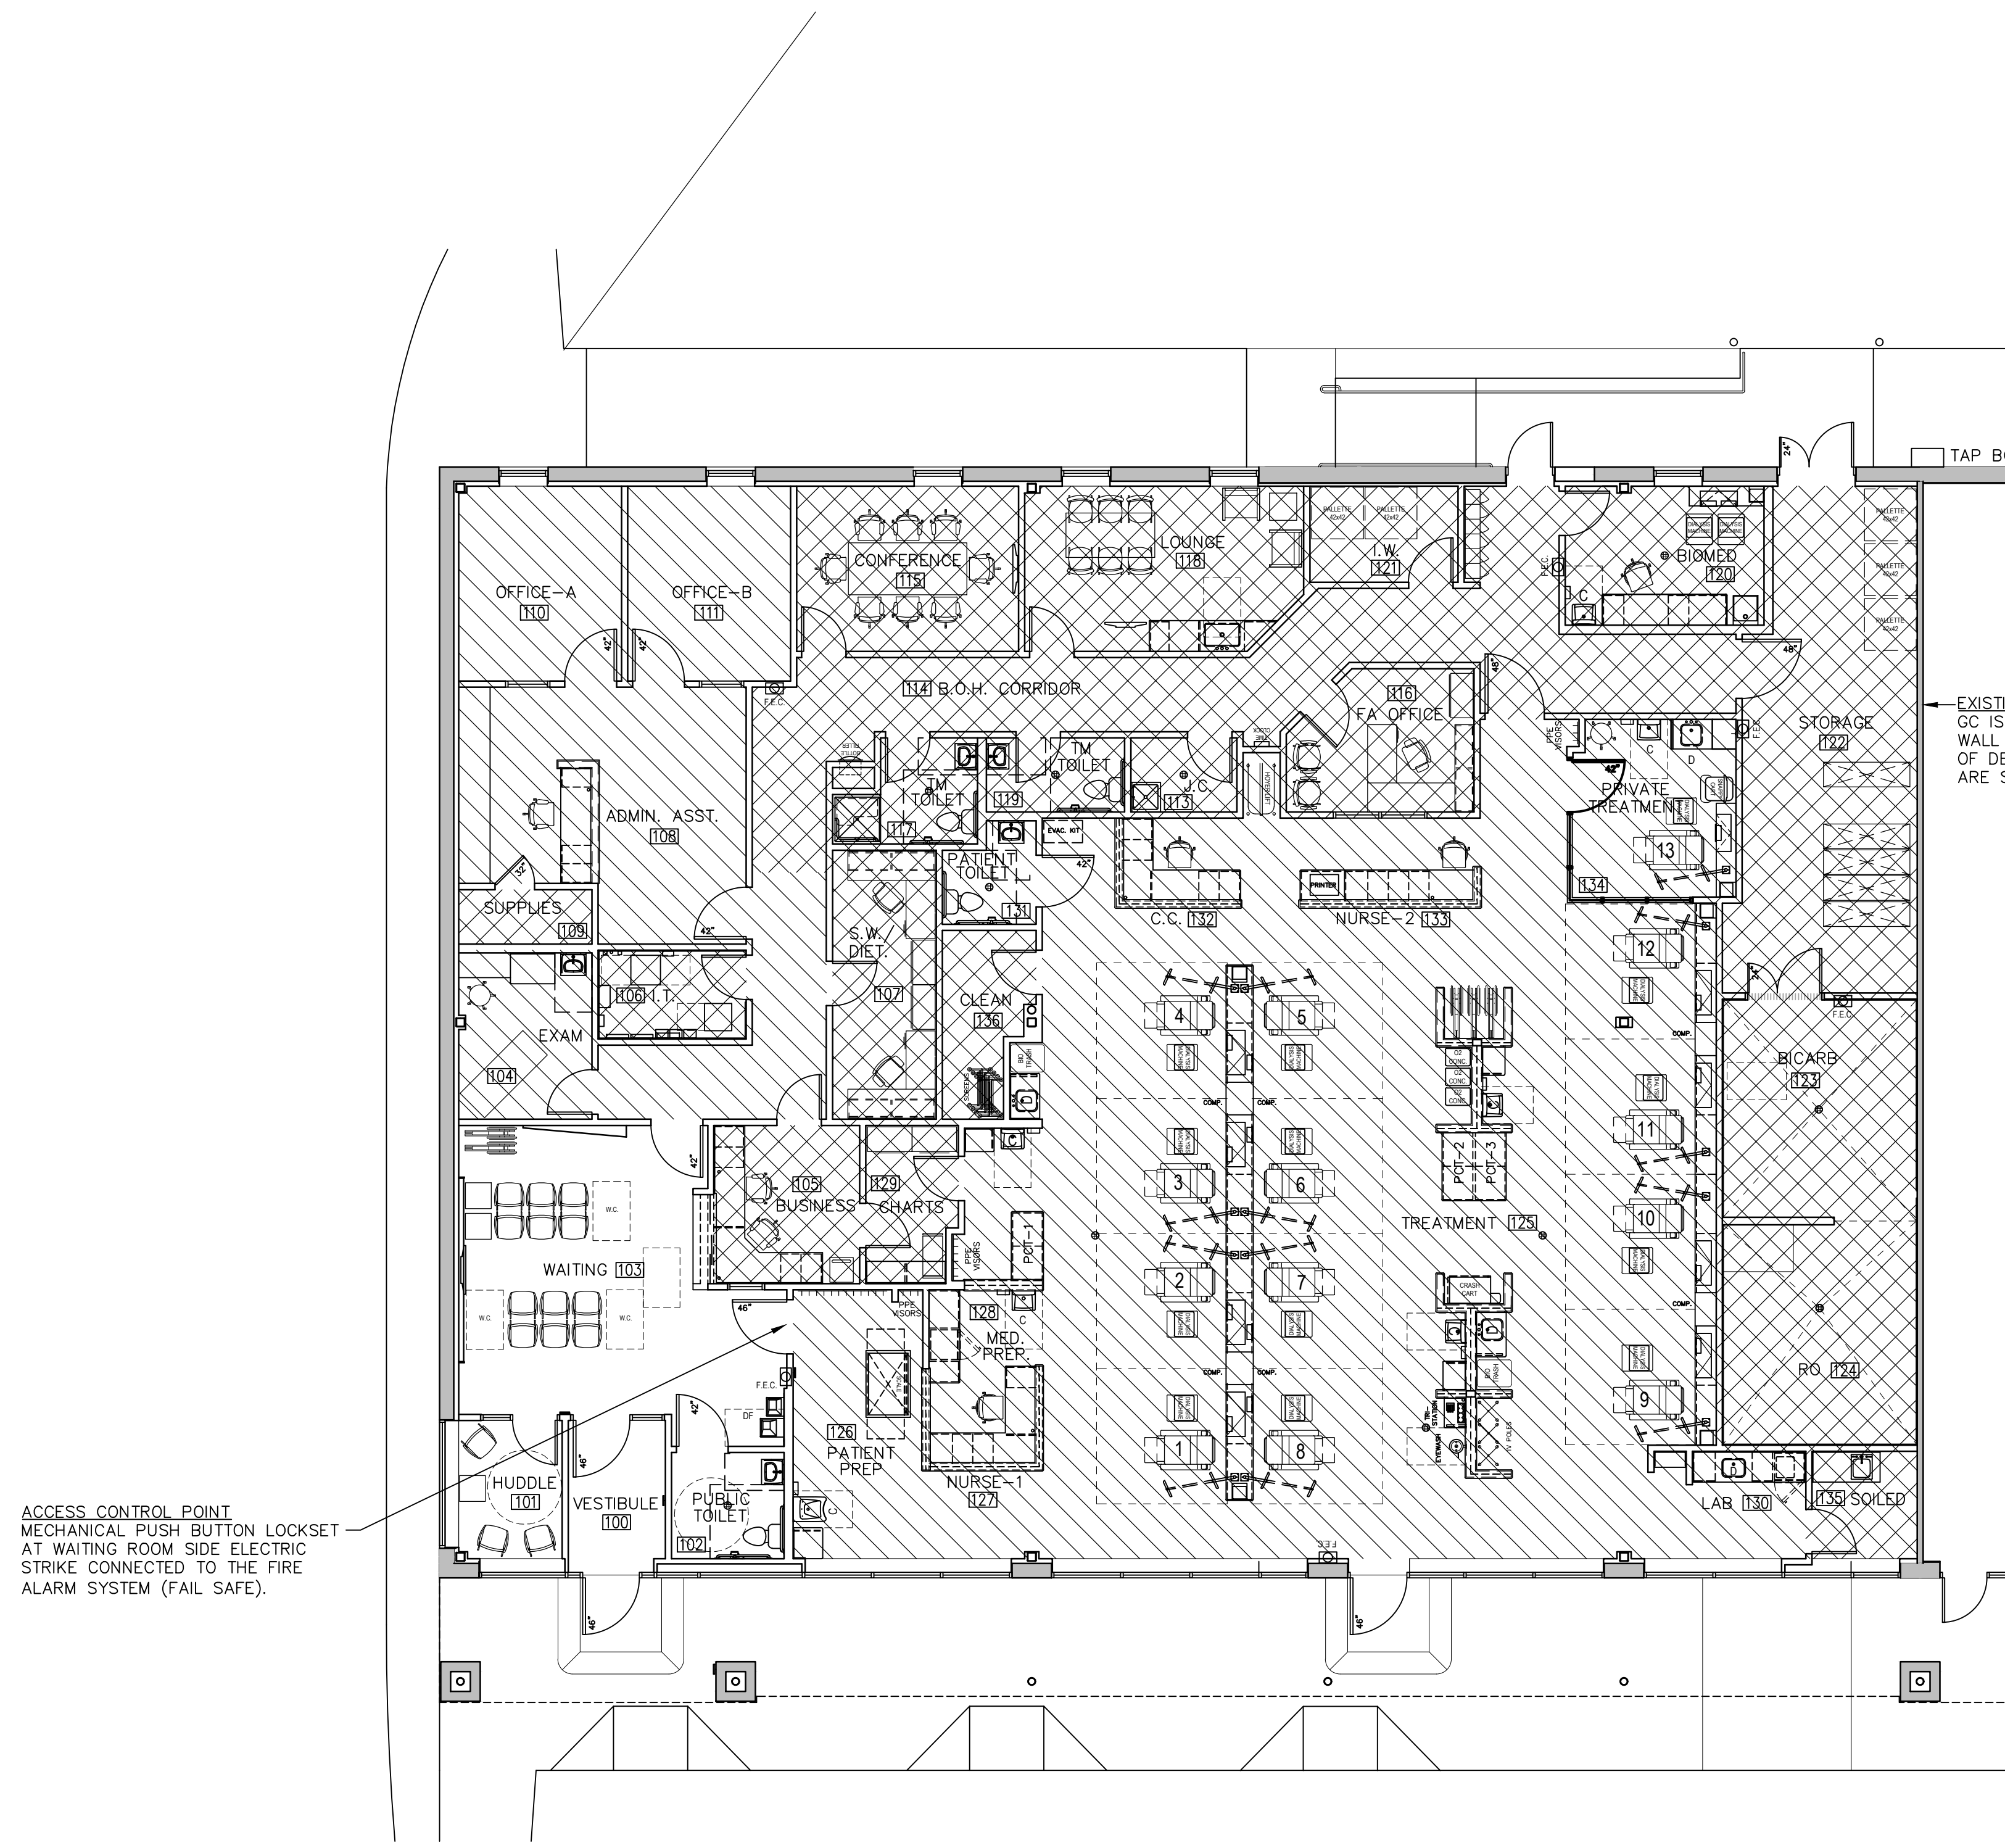




AS-BUILT DRAWING

RESTRICTIONS PLAN

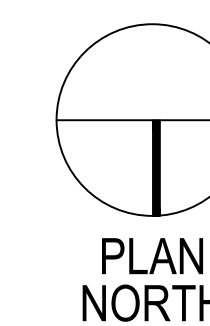SCALE: 1/8" = 1'-0"



- LEGEND**
-  RESTRICTED AREA — STAFF ONLY
LOUNGE, CONFERENCE, IT, ETC.
 -  SEMI-RESTRICTED AREA
TREATMENT, OFFICE
 -  UNRESTRICTED AREA — PUBLIC
WAITING ROOM

