


Property Key

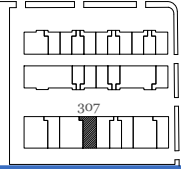


2,807 RSF +/- As Built Marketing Package

2750 Northaven Rd Suite 307
Dallas, TX 75229

Sheet **A1**
Of 1 Sheet(s)

Scale: Not to Scale
Sheet Size: 11" x 8.5"
Not For Construction

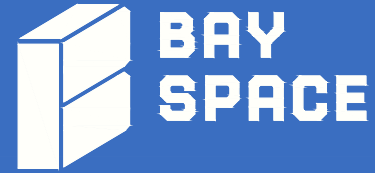


© 2025 HosScans, LLC.
All right reserved.
These drawings and any associated documents are protected under U.S. copyright law. No part of this work may be produced, distributed, or used in any form, by any method, for any purpose, without the prior written consent of HosScans, LLC. Unauthorized use is subject to legal action.

Usable Square Foot Analysis

OFFICE AREA:	670	25%
WAREHOUSE AREA:	2,037	75%
OVERHANG AREA:	100	
TOTAL AREA:	2,807	

Building Information

Deck Height:	15'10"
Clear Height:	14'5"
Ceiling Height:	8'10"
Sprinklered:	No
Mechanical Area:	N/A

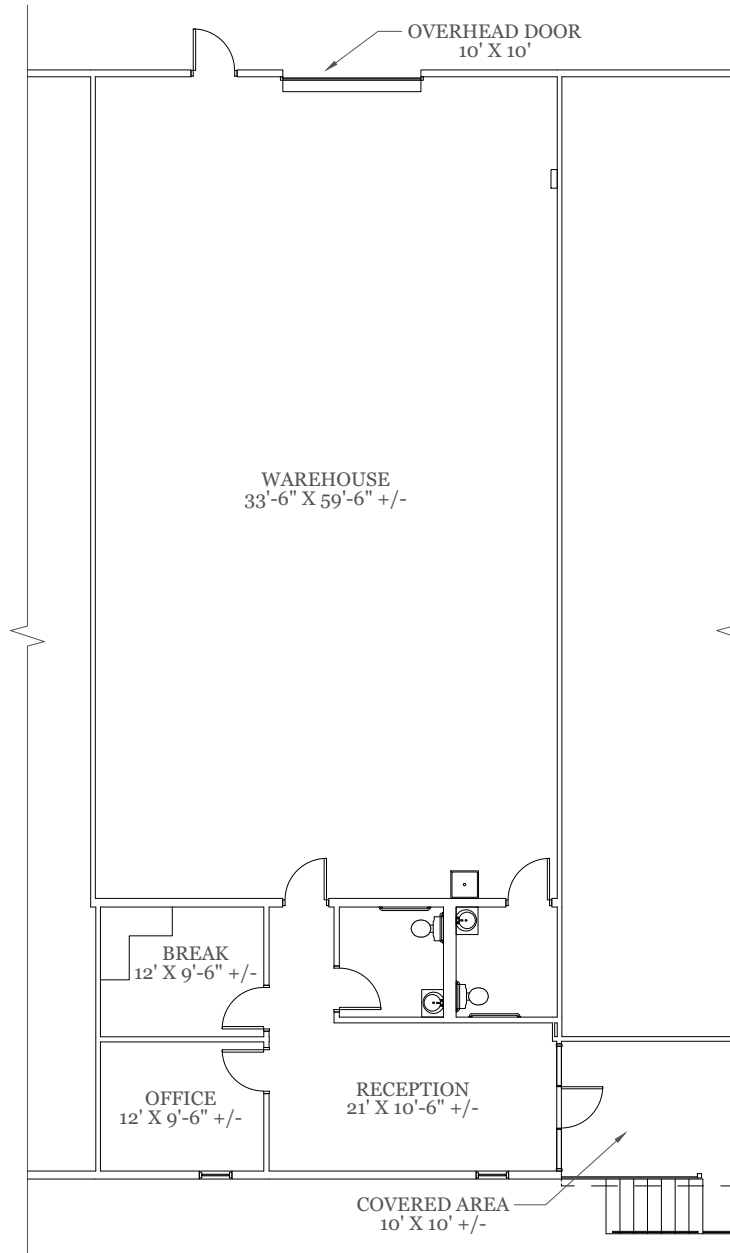

As Built Floor Plan for Marketing

