


URBAN TOWERS

222 W LAS COLINAS BLVD.
IRVING, TX 75038

URBAN TOWERS

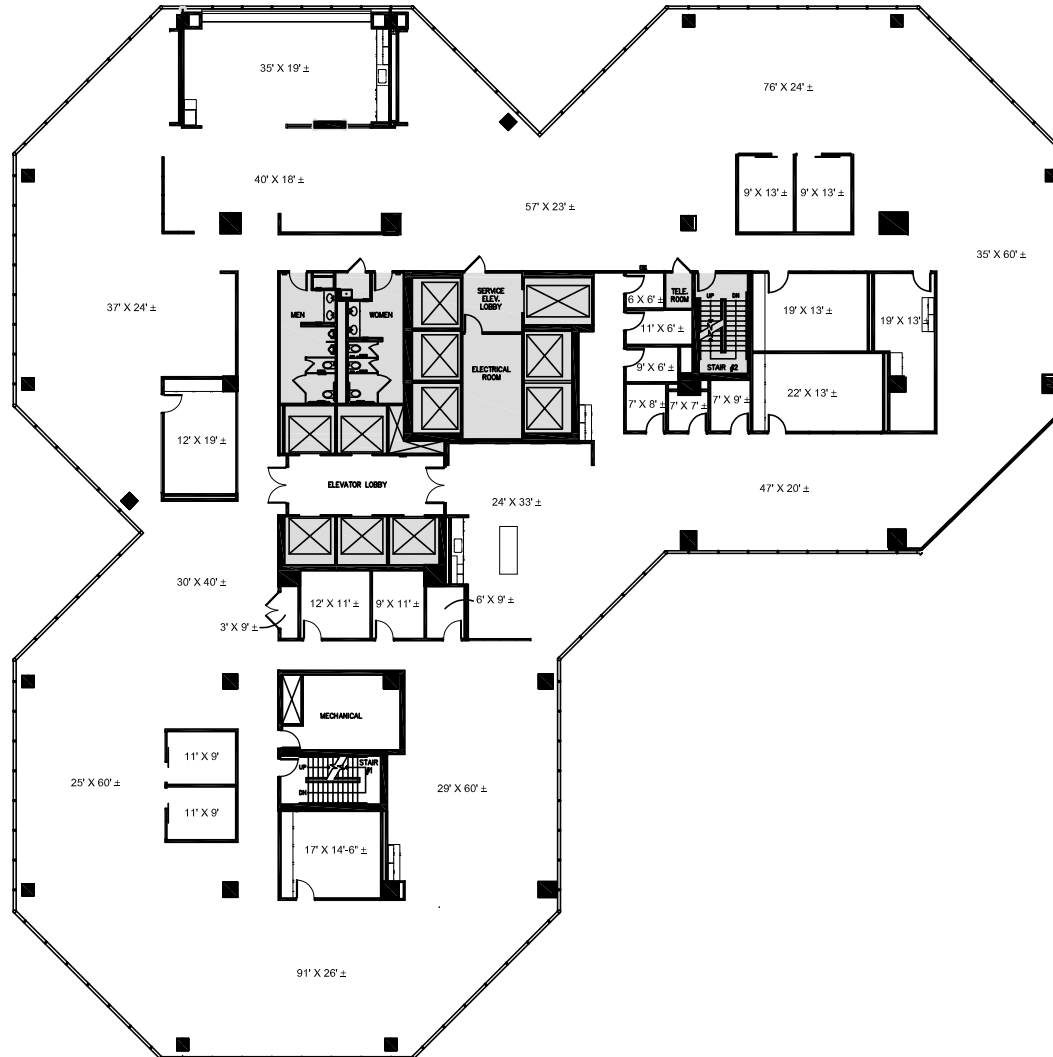

SUITE 1200N - 22,172 RSF



NEWMARK

