




REVISION NOTES:  
 VERIFY IN THE FIELD THAT THE INTERIOR WALLS BEING REMOVED ARE  
 NOT BY THE ARCHITECT OF RECORD FOR THE PROJECT AND  
 BEFORE REMOVING THE WALLS.

CONCRETE SLAB: THIS SLAB IS NOT A RETENTION SLAB BEING CUTTING  
 INTO THE SLAB PROVIDE A 5/8" x 5/8" x 1/2" ANCHOR BOLT  
 INTO THE SLAB SPACING OF 48" ON CENTER. THE STRUCTURE,  
 AND BE A DOUBLE SPAN OR BEADY ACCIDENTS.

**PROGRESS SET - NOT FOR  
 APPLICATION OR PERMIT**

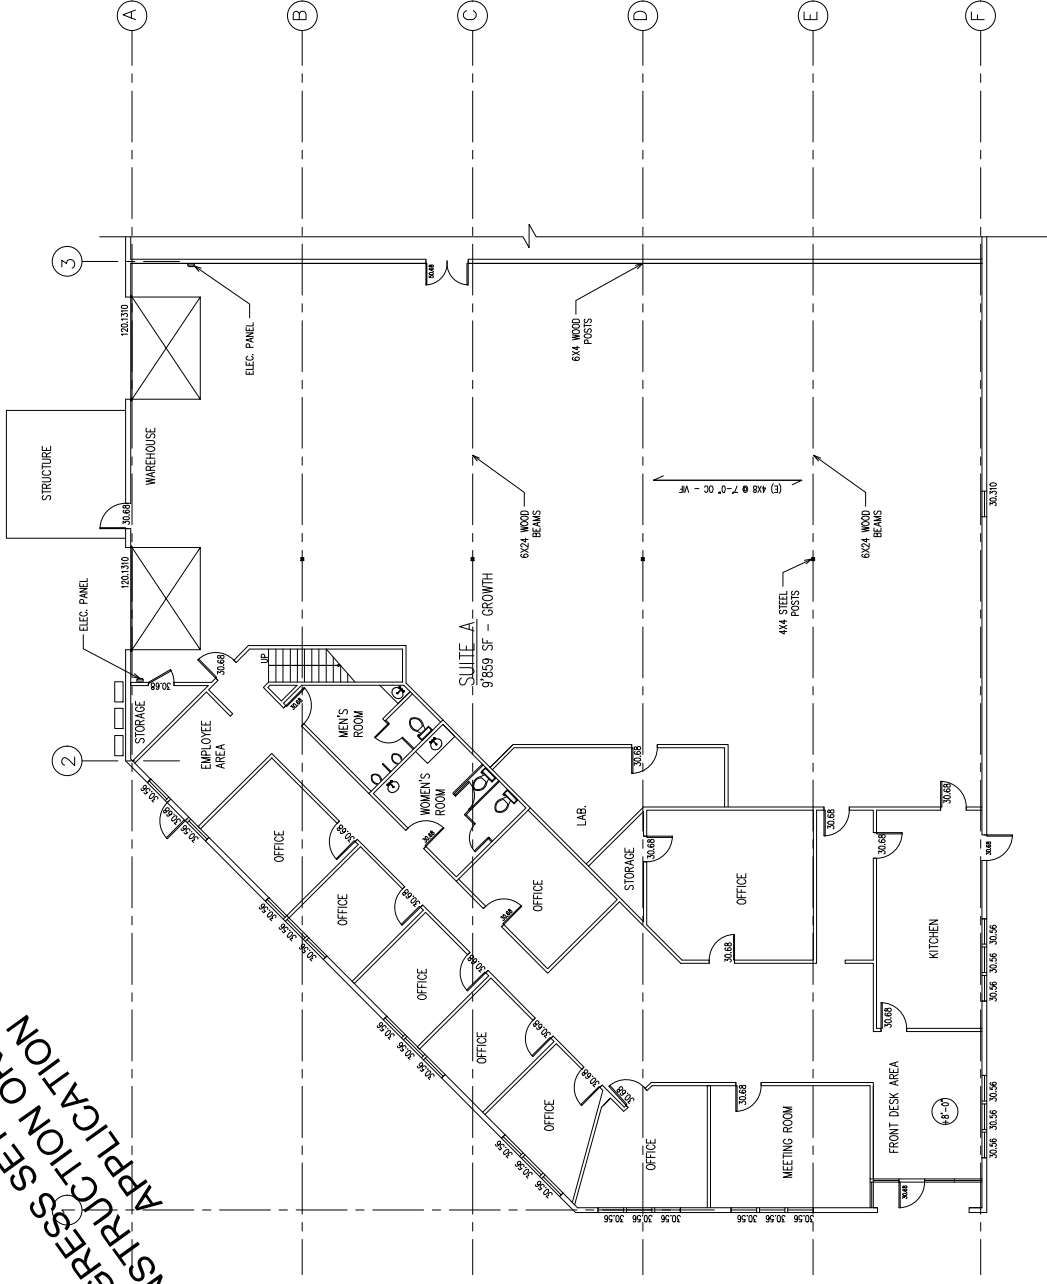

1 EXISTING 1ST FLOOR PLAN  
 SCALE: 1/8" = 1'-0"

VERIFY ALL DIMENSIONS IN FIELD. IN CASE OF DISCREPANCY, GC TO CONTACT ARCHITECT PRIOR TO CONTINUATION OF WORK.

REVISIONS
△
△
ROMAN CURTIS  
 ARCHITECT #C35019  
 3000 WILSON DESIGN STUDIO  
 PLEASANT HILL, CA 94523  
 510.632.0346  
 www.romanarchitect.com

AS-BUILT  
 1990 OLIVERA RD,  
 CONCORD, CA 94520

EXISTING AND  
 DEMOLITION PLAN  
 1ST FLOOR PLAN

DRAWN BY  
 PLG  
 CHECKED BY  
 PLG  
 ISSUED DATE  
 10/11/2023  
 SCALE  
 1/8" = 1'-0"  
 SHEET NO.  
 23-136  
 SHEET

A-2A





REVISIONS
△
△
ROMAN CURTIS  
 ARCHITECT #C35019  
 COLLEEN DESIGN STUDIO  
 3000 COLLEEN DRIVE  
 PLEASANT HILL, CA 94523  
 510.632.0346  
 www.colleendesignstudio.com

AS-BUILT  
 1990 OLIVERA RD,  
 CONCORD, CA 94520

EXISTING  
 ELEVATIONS

DRAWN BY  
 PLG  
 CHECKED BY  
 PLG  
 ISSUE DATE  
 10/11/2023  
 SCALE  
 1/8" = 1'-0"  
 JOB NO.  
 23-136  
 SHEET

A-2C

