


4TH FLOOR KEY PLAN

NOT TO SCALE

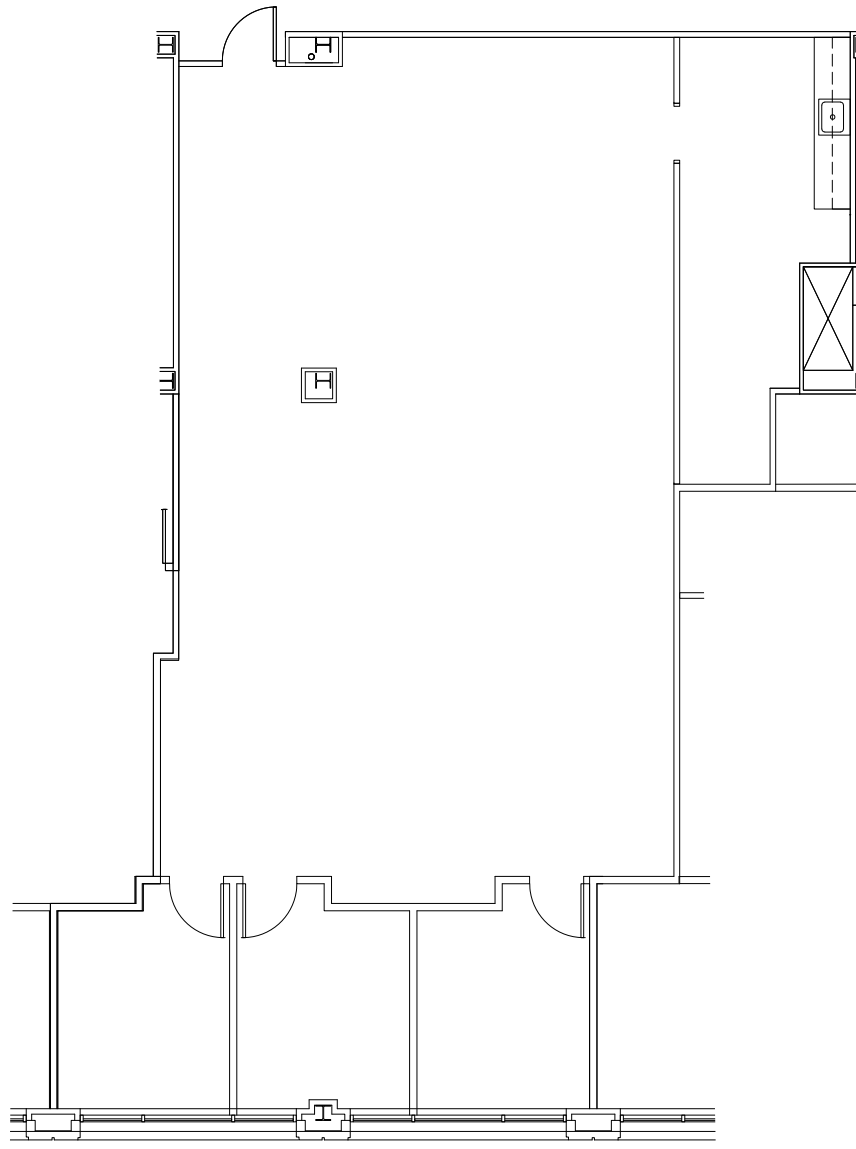

AS-BUILT

FOUR PARKWOOD - FOURTH FLOOR
500 E. 96TH STREET - INDIANAPOLIS, INDIANA