


1 2 3 4 5

D

C


B

A

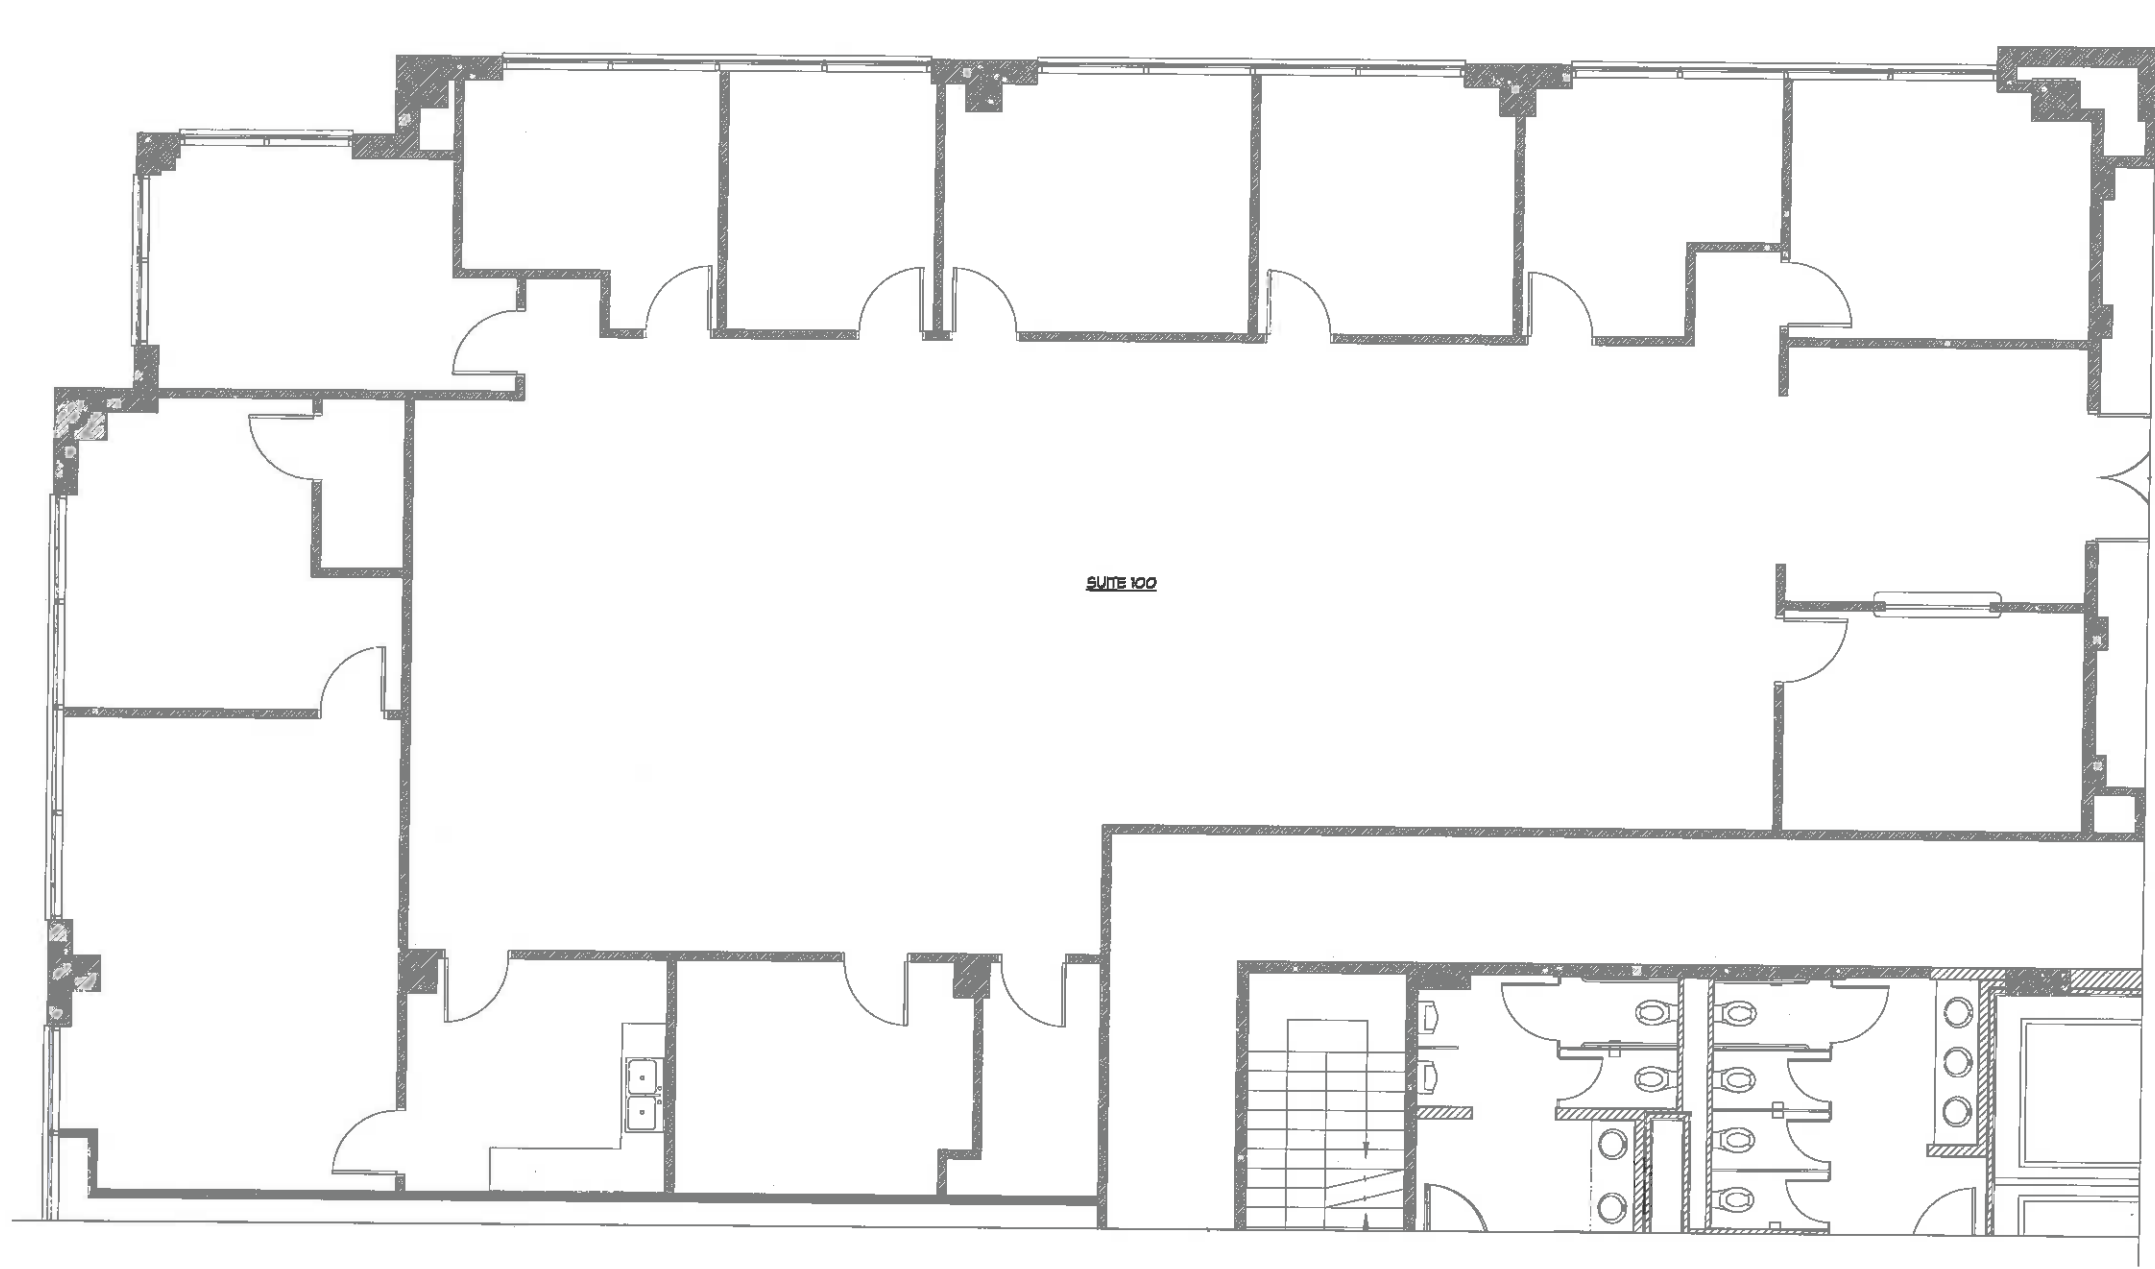

1 SUITE 100 FLOOR PLAN  
SCALE: 1/4" = 1'-0"

KEY PLAN 1ST FLOOR

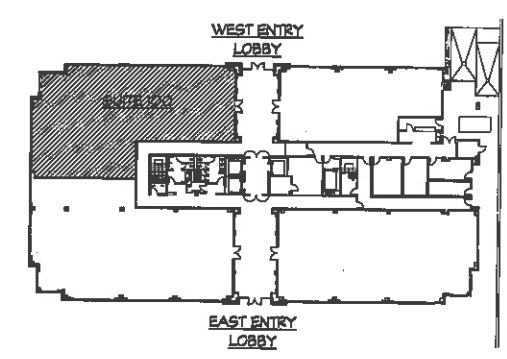

SCALE: 1/4" = 1'-0"

1 2 3 4 5



**dickinson**  
ARCHITECTS

Architecture|Interior Design|Planning  
771 Broad Street Suite 200  
Augusta, Georgia 30901  
(706) 722-7488  
mail@dickinsonarchitects.com  
www.dickinsonarchitects.com



Member of the  
American Institute of  
Architects

THIS DRAWING IS THE PROPERTY OF DICKINSON ARCHITECTS, P.C. AND IS NOT TO BE REPRODUCED OR COPIED IN WHOLE OR IN PART OR USED FOR UNAUTHORIZED REPRODUCTION. THE OWNER OF THIS ANY OTHER PERSONS OR ORGANIZATIONS FOR THE RELEASE OF DICKINSON ARCHITECTS, P.C., AND TO BE HELD HARMLESS BY DICKINSON ARCHITECTS, P.C.

PROJECT TITLE:  
**AUGUSTA  
RIVER  
FRONT  
CENTER -  
AS-BUILTS**

REVISIONS

REV #	DATE	APPROV BY	REVISION

DA PROJECT NUMBER & NAME:

0403.10

DRAWING TITLE:

**SUITE 100 FLOOR  
PLAN**

DRAWING NO.:

**A101**