
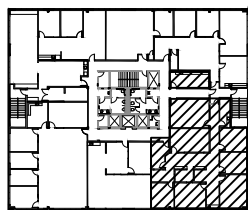


CORPORATE PARK

10 CORPORATE PARK, IRVINE, CALIFORNIA

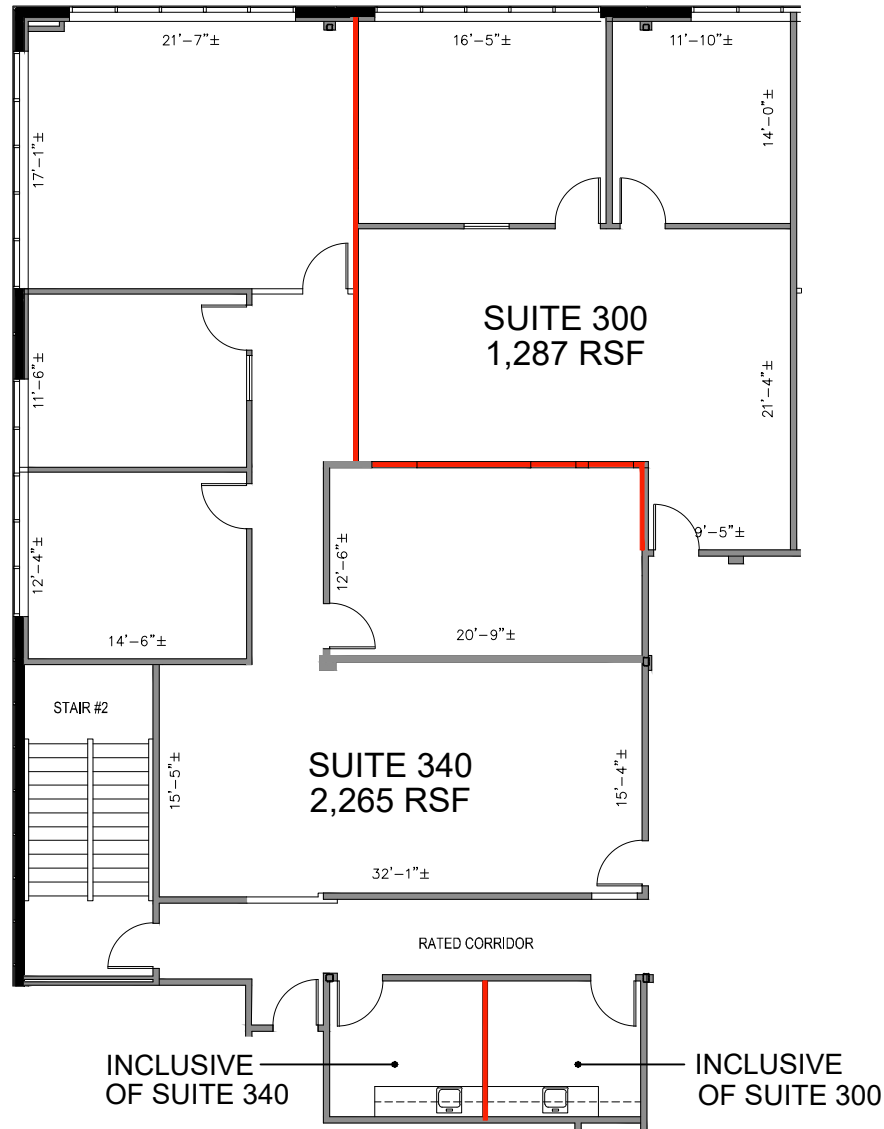

KEY PLAN

SUITE 300 & 340 SPLIT HYPO OPTION 5 3,552 RSF



10 Corporate Park, LLC/ Cadtronics, Inc. does not warrant that the information contained herein represents "As-Built" or existing field conditions. The Lease Outline Drawing is provided for reference purposes only. All information and conditions must be field verified by Tenant's architect and/or contractor.