


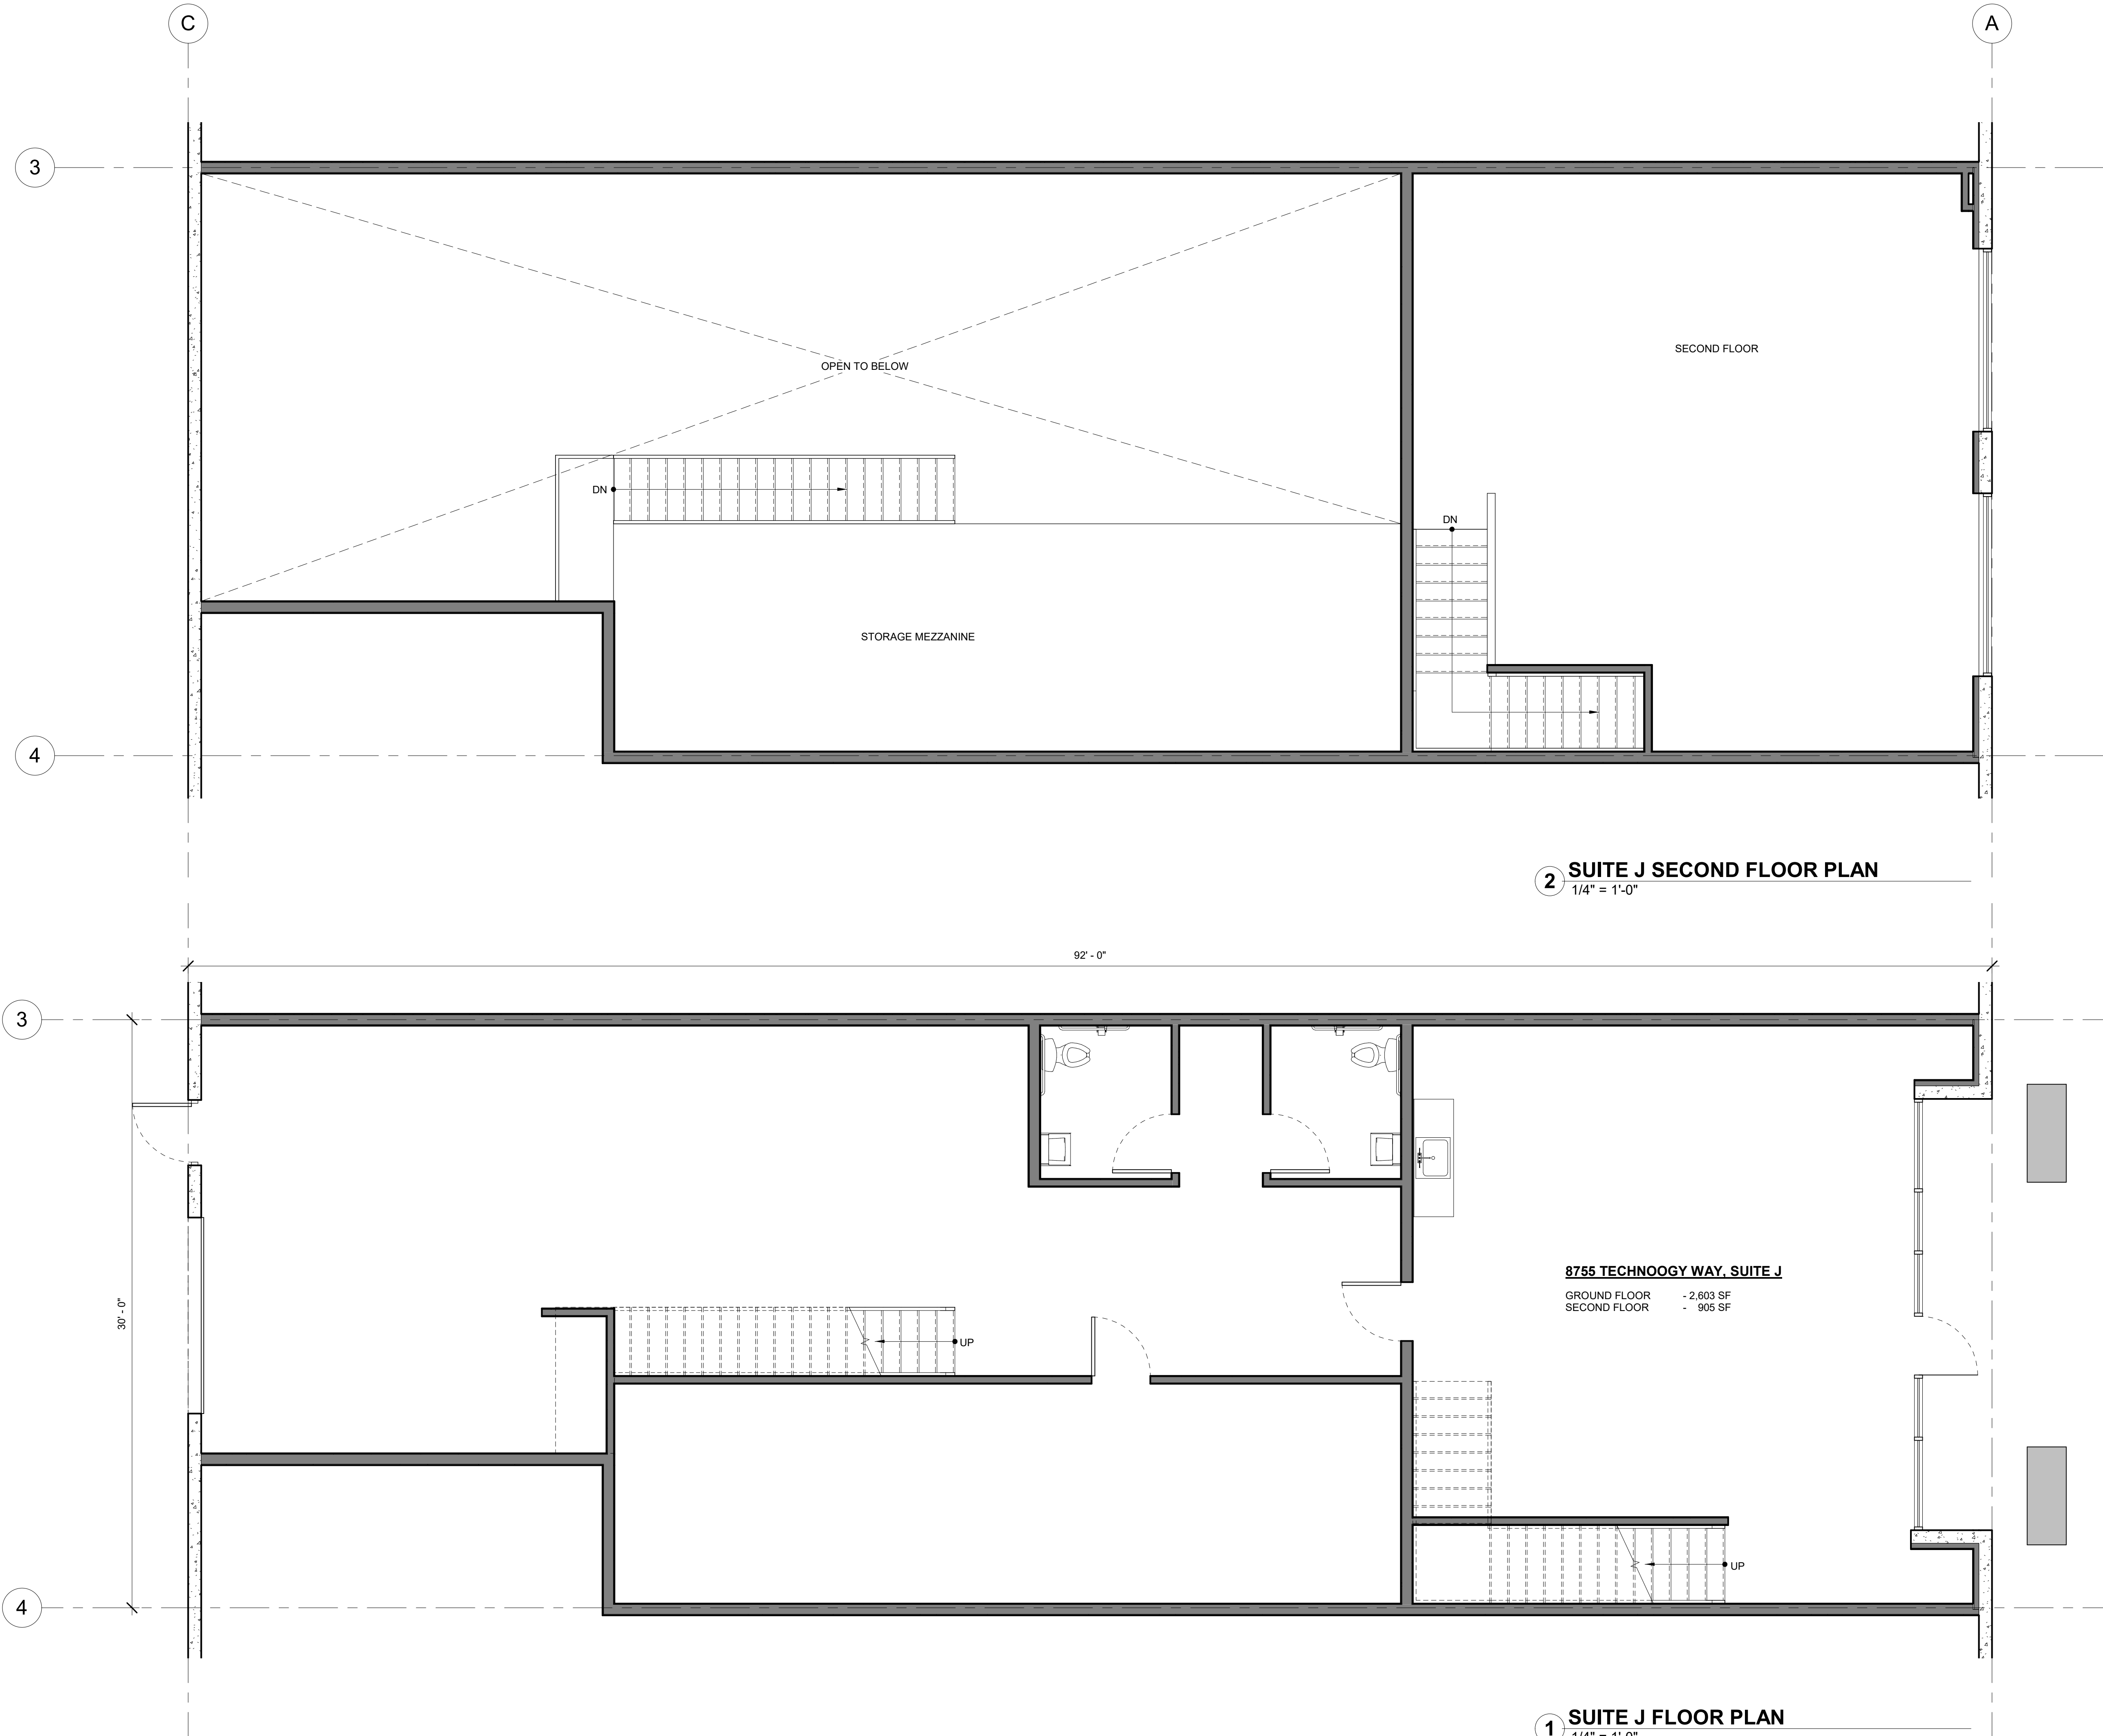

General Notes		
No.	Revision/Issue	Date

Seal:

Architect:

JOEY LASSONDE DRAFTING
AND Design

775-527-2483
1975 SELMI DRIVE, SUITE 116
RENO, NEVADA 89512

Copyright 2020 All Rights Reserved
Drawings, specifications and other documents including those in electronic form, prepared by the architect are Instruments of Service for use solely with respect to this Project. The Architect shall be deemed the author and owner of these instruments of Service and shall retain all common law, statutory and other reserved rights, including copyrights.

Project Name and Address

SUITE J RECORD PLAN

8755 TECHNOLOGY WAY
RENO, NEVADA

Title

FLOOR PLAN

Approvals

Date	Job Number	Sheet
05/11/2022	.	A2.1
Scale	1/4" = 1'-0"	