


1045 West Queen Creek Road

Chandler, Arizona

Suite 1

Suite 5

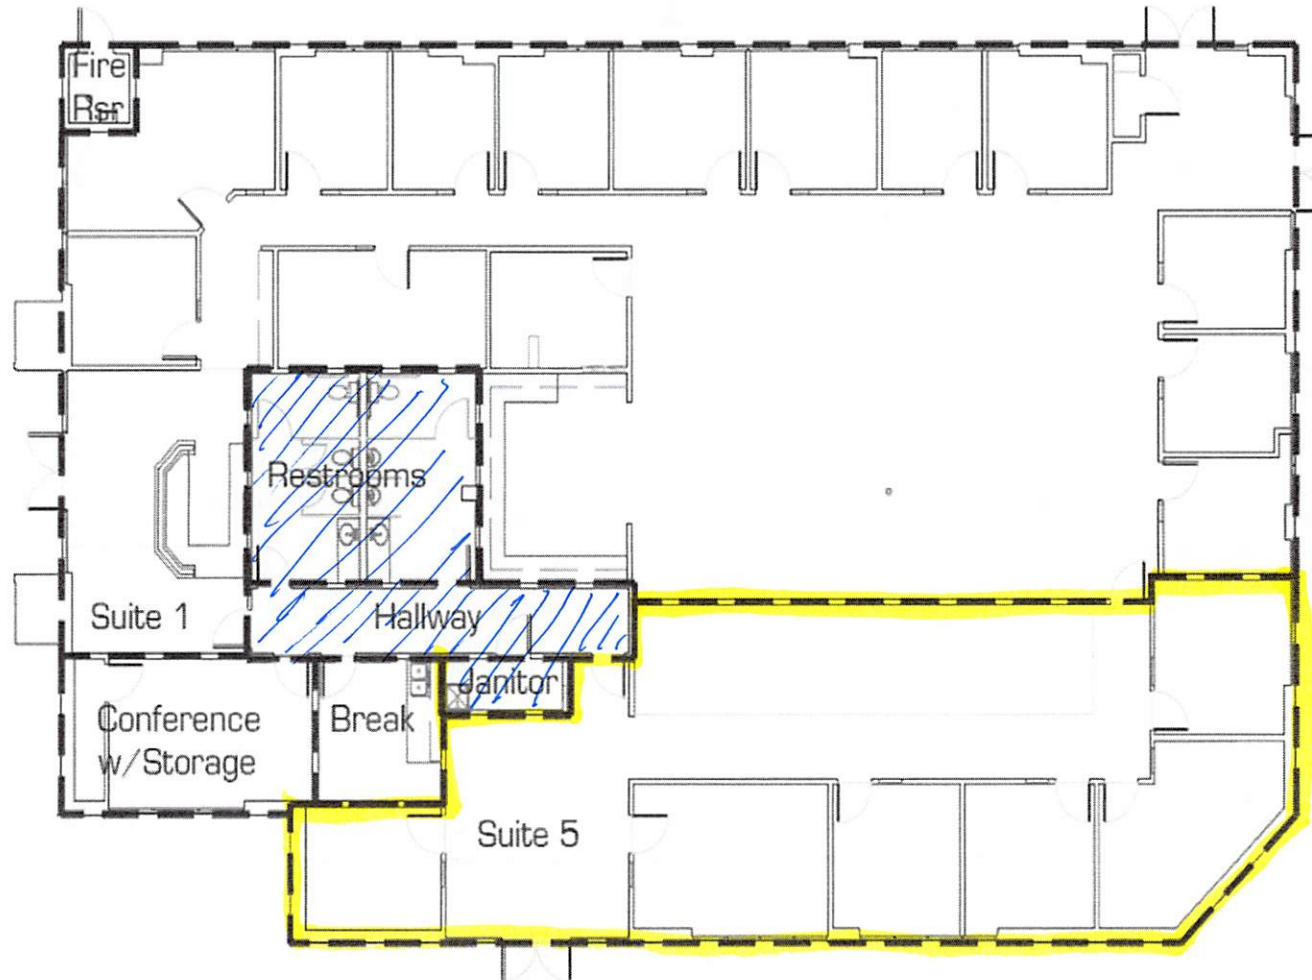

As-Built - floor plan - area separation

scale: nts

30.March.2025

*All dimensions are approximate at ± 3"

*All information is of general nature

precisionDIMENSIONS

as-built & survey
602.790.6412

