



American Building Calculations

3853 Northdale Blvd
Suite 253
Tampa, FL 33624
813-600-5472
www.abccalc.biz



HORIZON EQUITIES

Client:
1515 Pine Street
SUITE 100
Lakewood, NJ 08701
888.244.1611

Property:
2200 51st St
Sarasota, FL 34234



This is an unpublished existing condition measurement / as-built floor plan document created by American Building Calculations, Inc. Any site plans are outlines only and are not to be considered valid engineering drawings. This document has been created based on the contract for this project agreed upon between the owner and American Building Calculations, Inc. Any publication, copying, distribution or exhibiting of this document with attributes identifying American Building Calculations, Inc. is not permitted in any fashion without the written permission of American Building Calculations, Inc.

Field Drawn By:	HE
Drawn By:	JM
Published Date:	06/12/23
Revision Date:	N/A




Scale:
CUSTOM

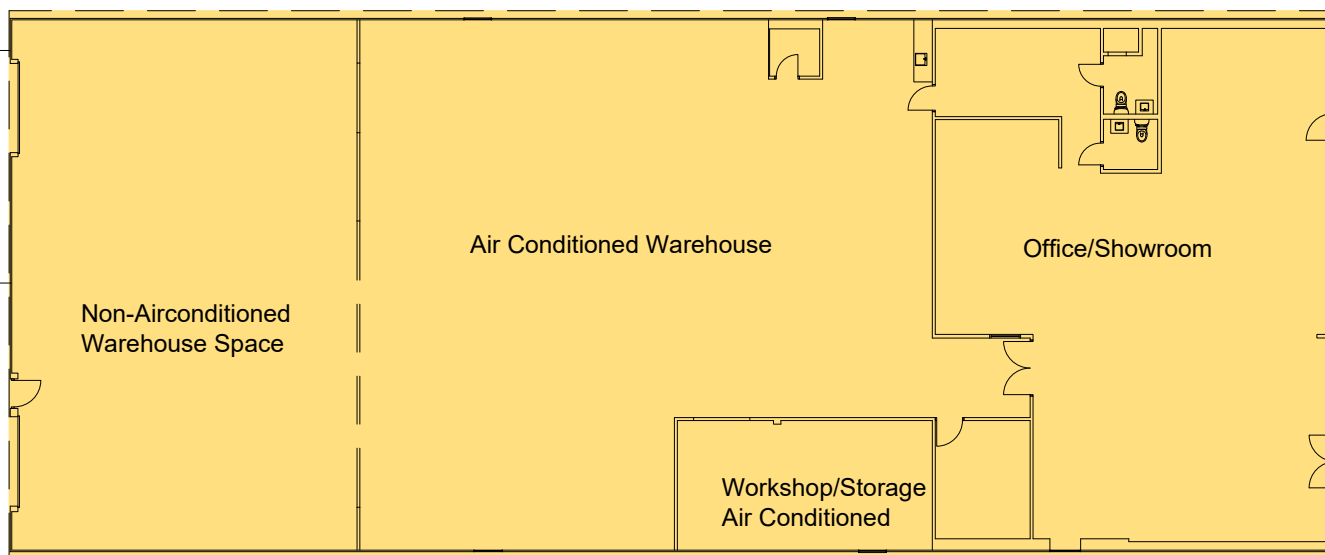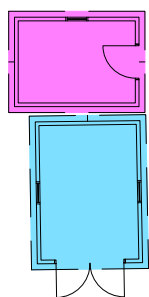

FIRST FLOOR
FLOOR PLAN



ANSI / BOMA Z65.2-2012

	MAIN BUILDING	-	9,347.37	SF
	OUTBUILDING 1	-	229.61	SF
	OUTBUILDING 2	-	176.42	SF
	DRIPLINE AREA	-	9,753.40	SF

