

SUN CITY CARDIAC CENTER

10415 W THUNDERBIRD BLVD | SUN CITY, AZ 85351


Floor 01

Suite 100

AS-BUILT

11,306 SF

AVAILABLE

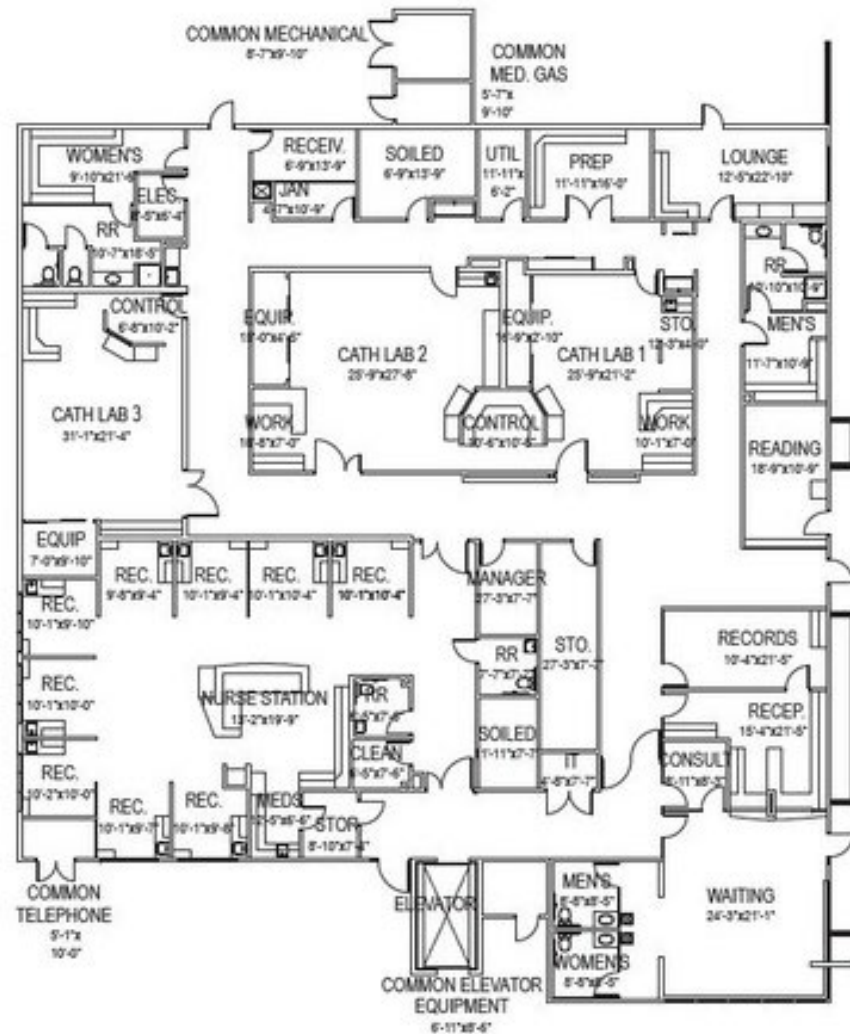

RACHAEL THOMPSON
Senior Vice President
602.513.5122
rachael.thompson@kidder.com

PERRY GABUZZI, CCIM
Senior Vice President
602.513.5116
perry.gabuzzi@kidder.com



View Portfolio

km Kidder Mathews