



ALPHA PLAZA

4885 ALPHA ROAD, DALLAS, TEXAS 75244

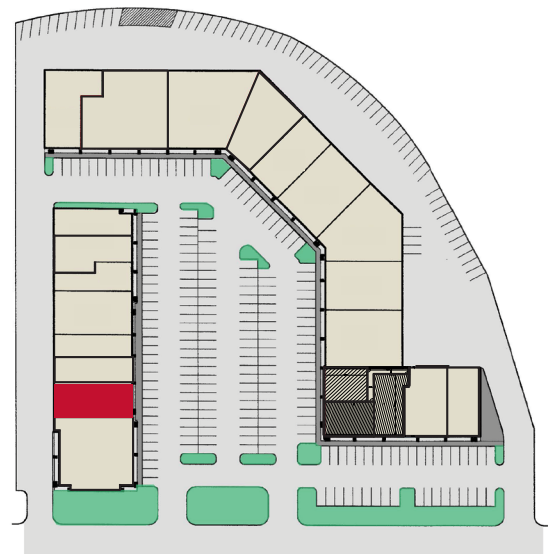

Suite 110 - 2,422 rsf

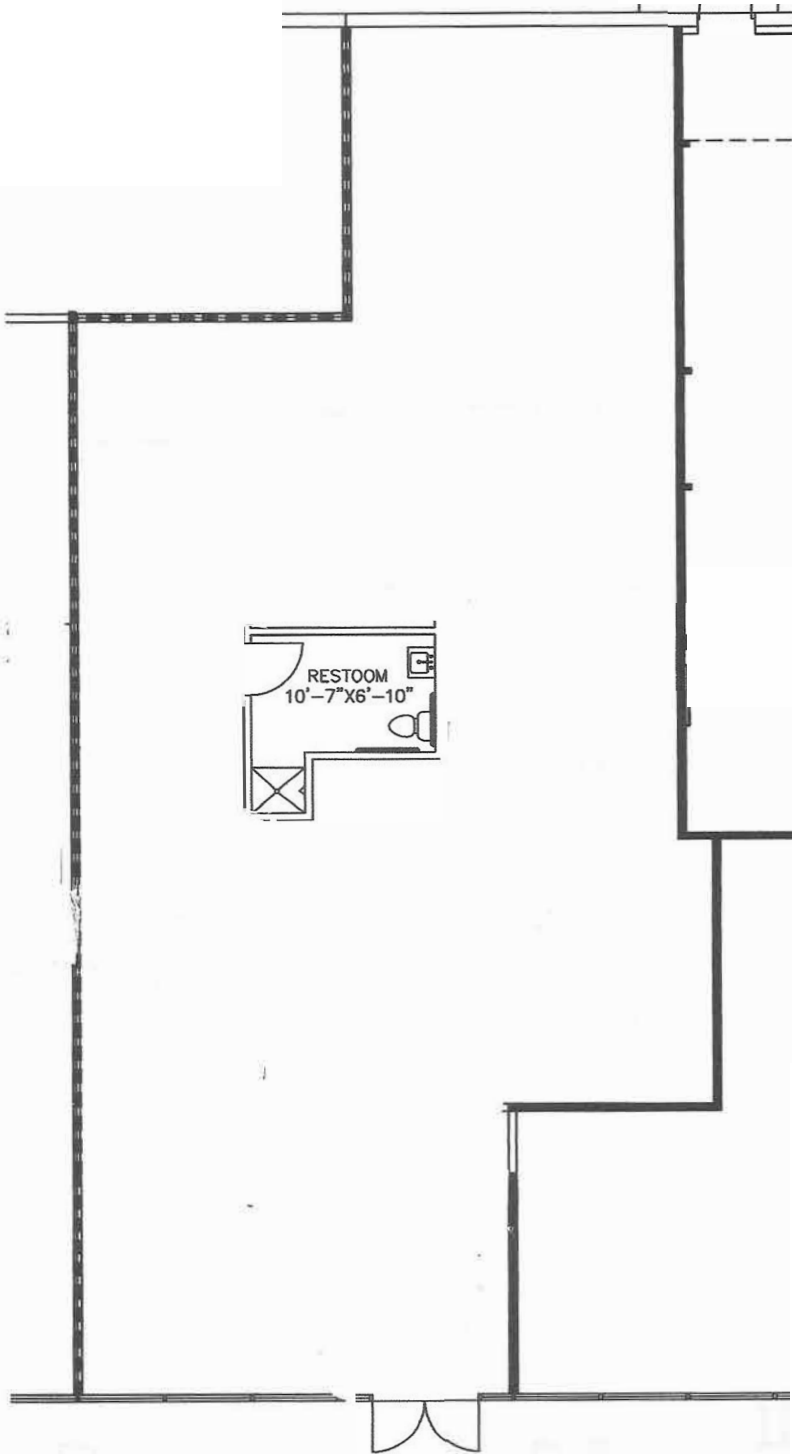

Melanie Hughes

972.776.7046 (office) | 214.507.6060 (cell)
mhughes@bradford.com

Erik Blais

817.921.8179
eblais@bradford.com

Bradford Commercial Real Estate Services
www.bradford.com

