


2nd FLOOR PLAN

1/8"

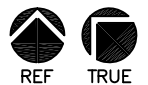

THUNDERBIRD AIRPARK CENTER

7575 E. REDFIELD RD. SCOTTSDALE, AZ 85260

SUITE #213 (AS-BUILT)

JOB # 2503-00

1-27-2025

DRAWN BY: JT