


# Property Key

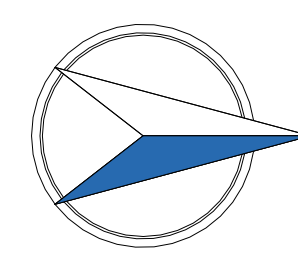

# Alt Springs As Built Marketing Package

402 Northlake Blvd, Alt Springs, FL 32701, US

Building: 402

Suite: 1026

Sheet **E1**

Scale: Not to Scale  
Sheet Size: 42" x 30"  
Not For Construction




# BAY SPACE

## Usable Square Foot Analysis

Office Area	2,568	100 %
Warehouse Area	0	0%
Total Area	2,568	

## Building Information

Deck Height:	N/A	
Clear Height:	10' - 1 1/2"	
Ceiling Height:	9' - 0"	
Sprinklered:	<input checked="" type="checkbox"/> Yes	<input type="checkbox"/> No
Mechanical Area:	0 SQFT	

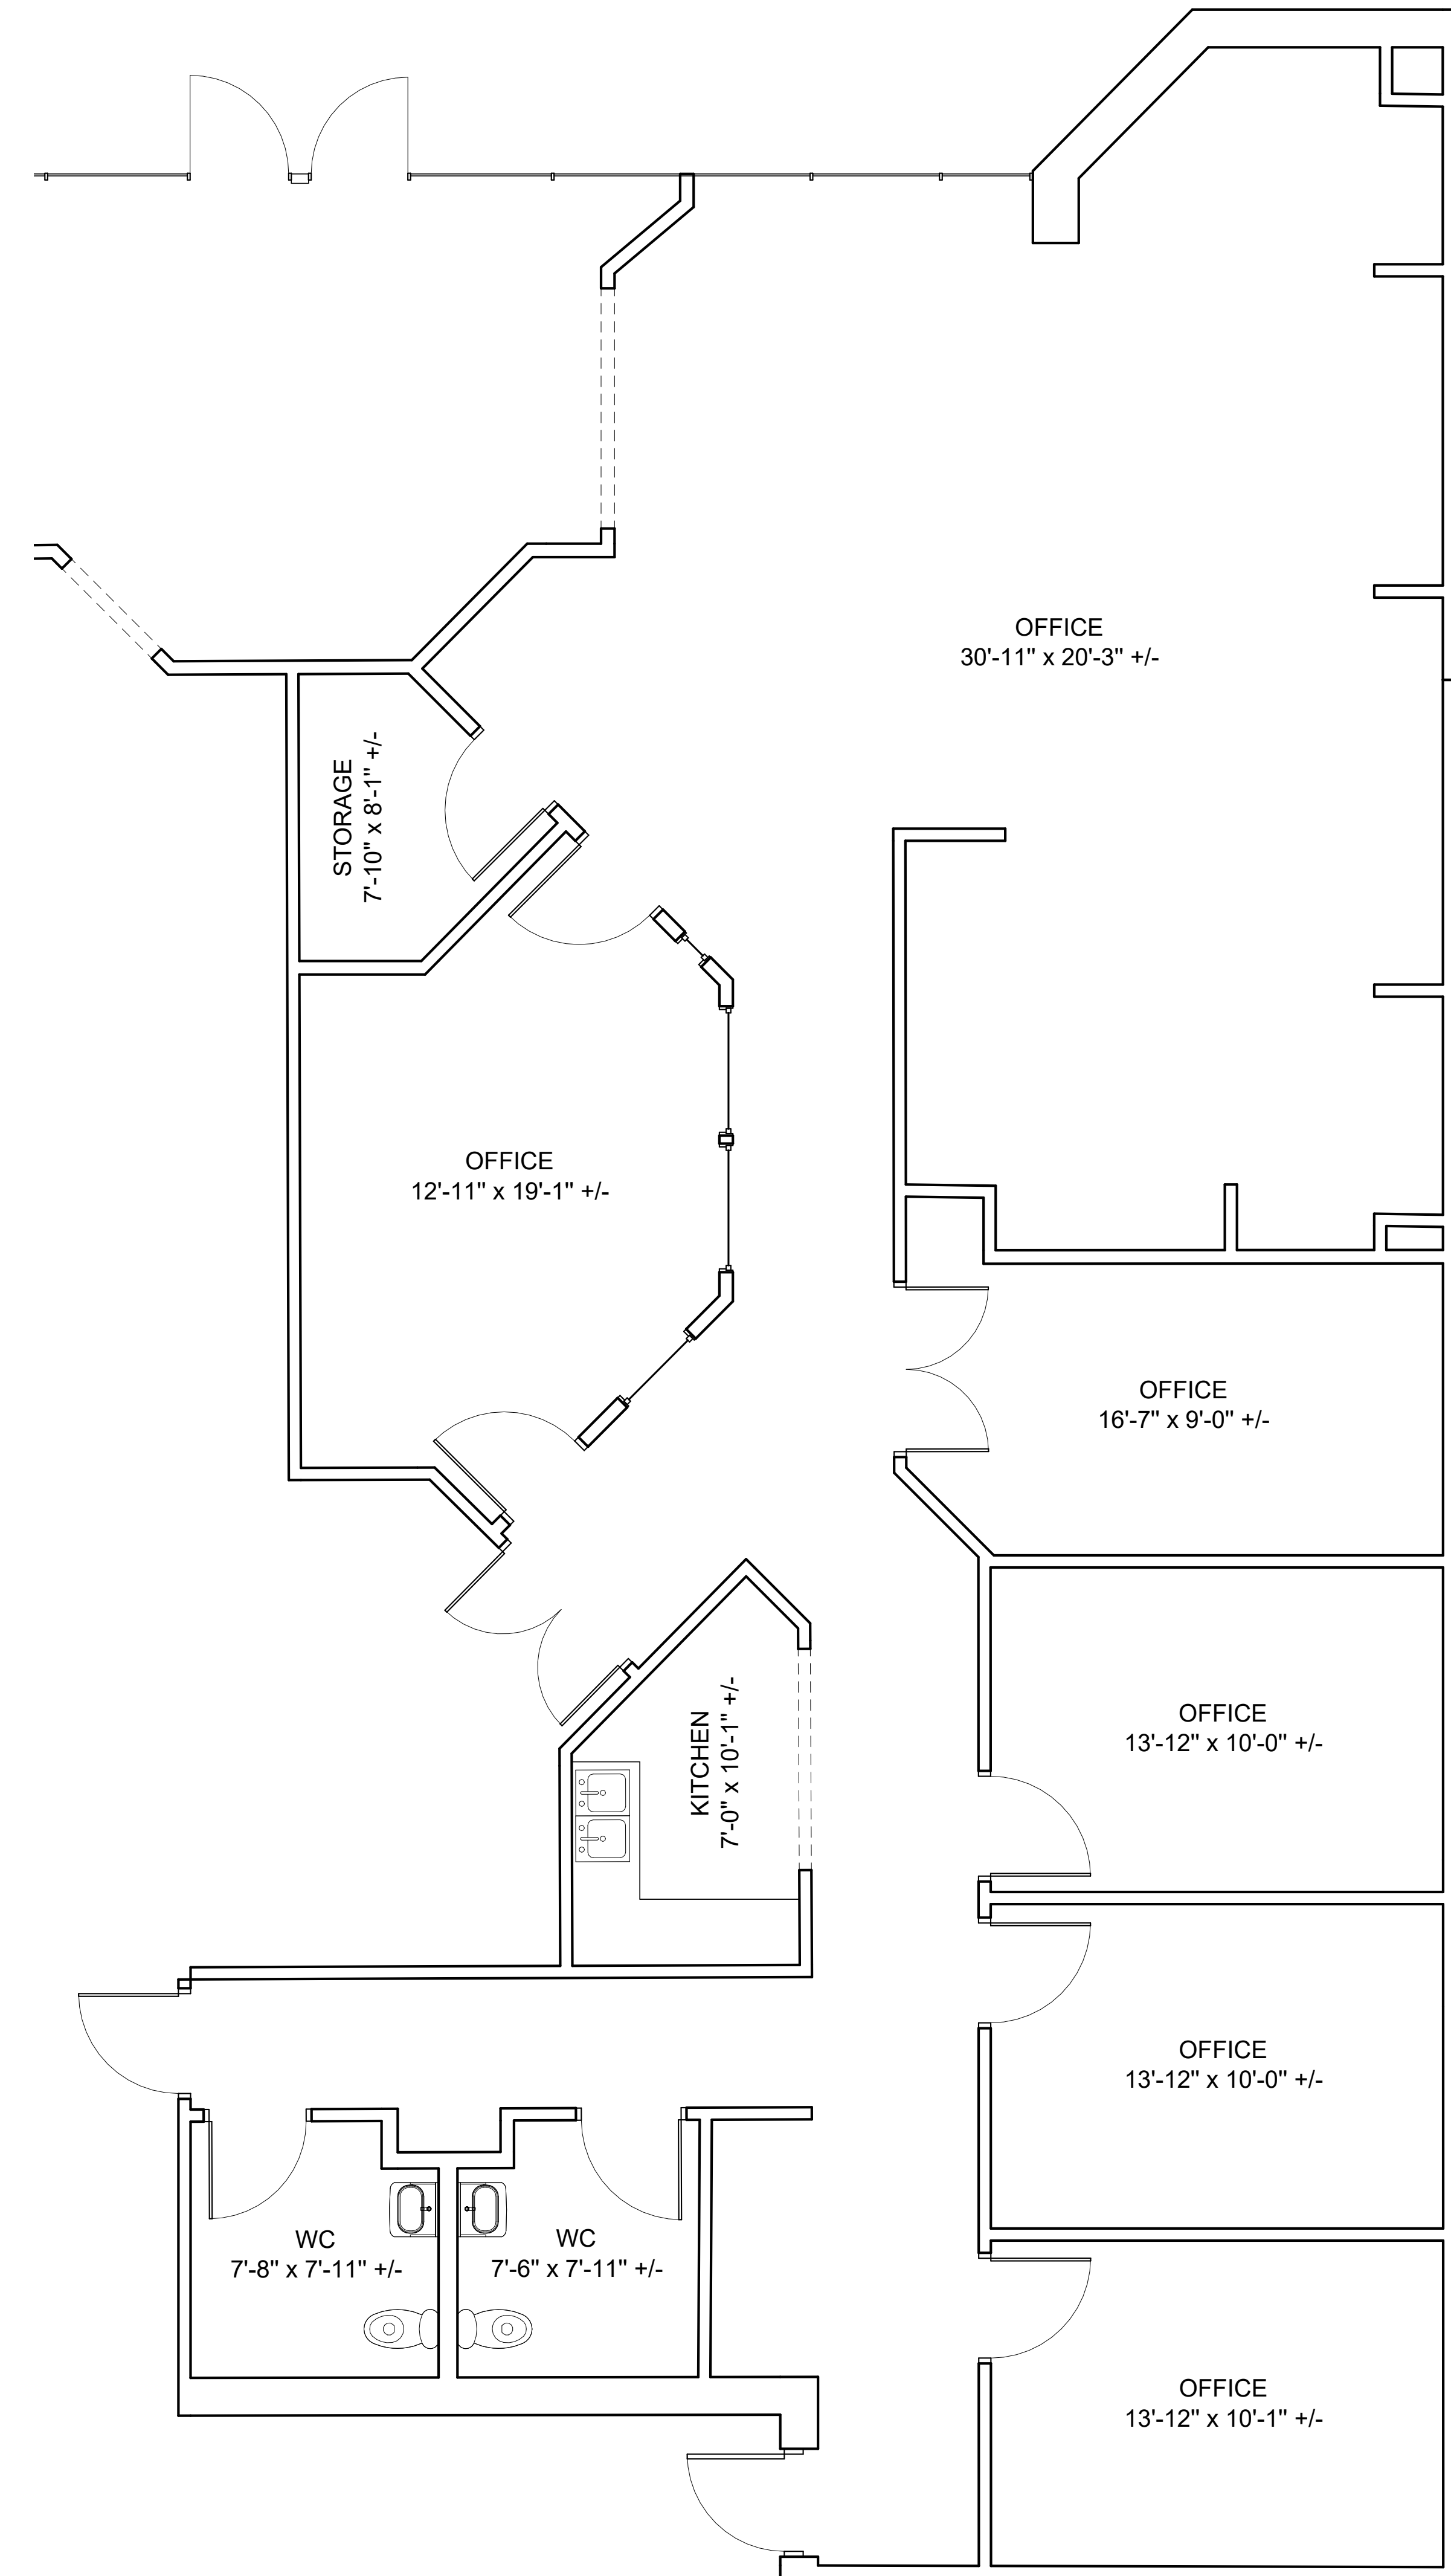

As Built Floor Plan for Marketing

