


South Terraces

Suite 860 | 5,432 RSF


115 Perimeter Center Place | Atlanta, GA 30346



TERRACES

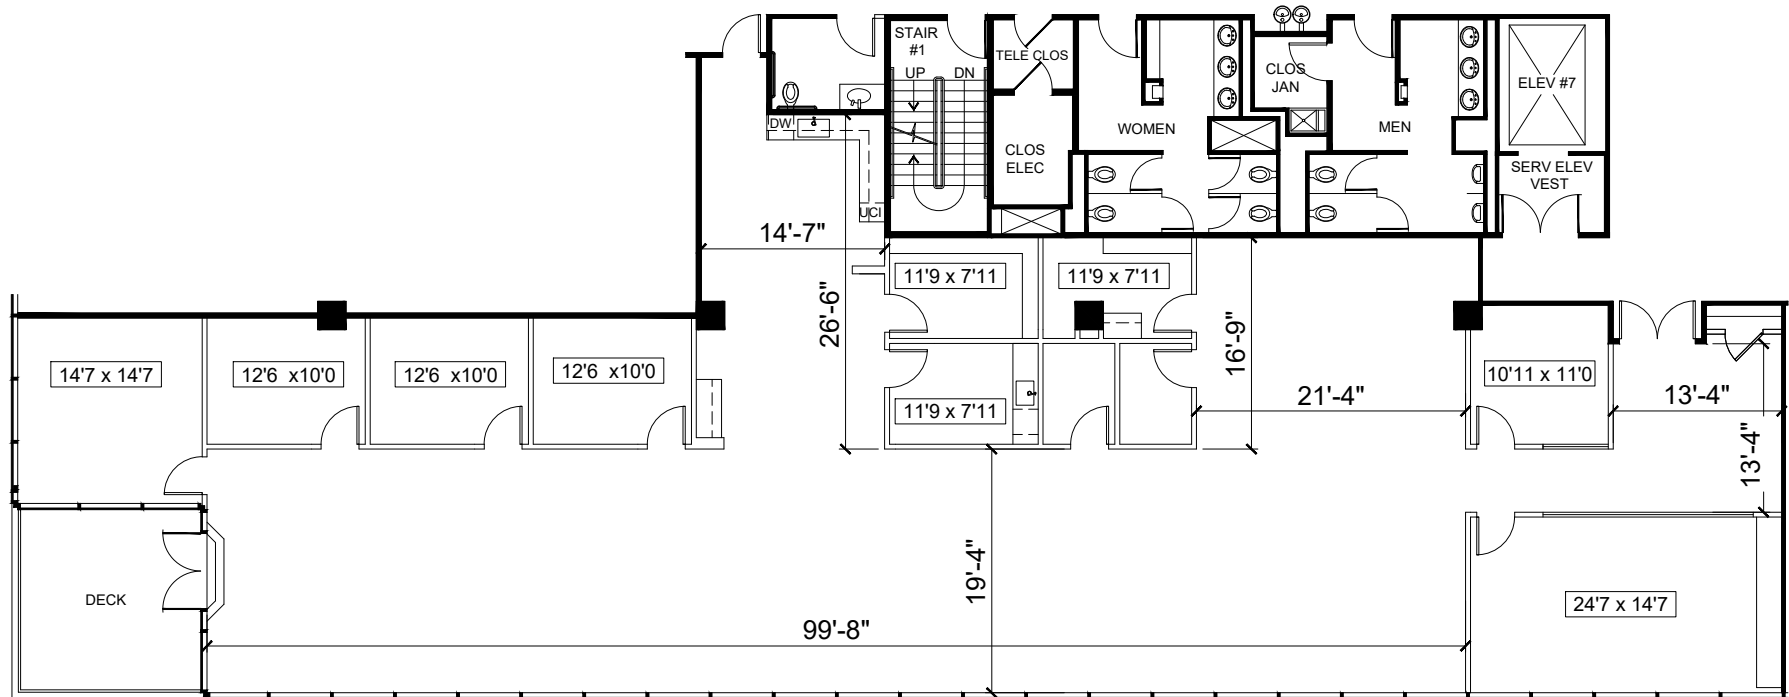

Brooke Dewey 404.995.2138
Glenn Aspinwall 404.995.2139

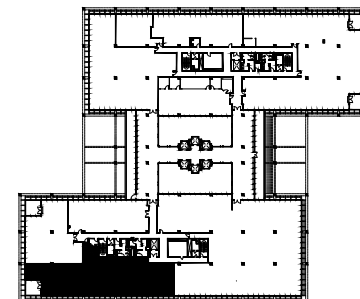

KEY PLAN



As Built | 06.19.25