


1. ALL BEARINGS REFERENCED ON TEXAS SOUTH CENTRAL COORDINATE SYSTEM (NAD 83).
2. ALL DISTANCES SHOWN HEREON ARE IN SURFACE.
3. THIS IS NOT A BOUNDARY SURVEY.

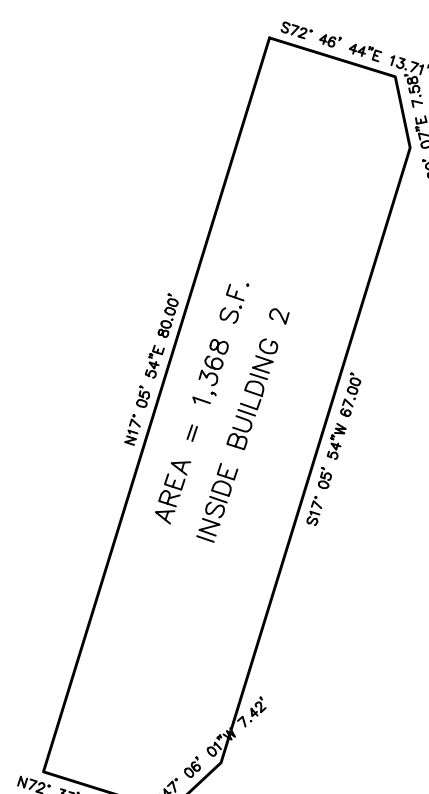

07-16-2026
DATE

L E G E N D	
•	PL POWER POLE
B or BB INLET	VOL VOLUME
POST	PG PAGE
X	H.C.F.C. HARRIS COUNTY CLERK'S FILE
FIRE DEPARTMENT CONNECTIONS	H.C.F.C.D. HARRIS COUNTY FLOOD CONTROL DISTRICT
HIGHBACK	HARRIS COUNTY MAP RECORDS
BUILDING	H.C.R.D. HARRIS COUNTY DEED RECORDS
WOOD FENCE	BL BUILDING LINE
CHAIN LINK FENCE	U.E. UTILITY EASEMENT
OVERHEAD LINE	IF AS PER RECORD DRAWINGS
UNDERGROUND LINE	FINISH FLOOR EXISTING ELEVATION
MAILBOX	LP LIGHT POLE
GAS METER	CO CLEAN OUT
HC HANDICAP	GA GUY ANCHOR
FOUND IRON ROD	WM WATER METER
UNDERGROUND CABLE	EB ELECTRICAL BOX
SET MONUMENTS BY TERAN GROUP	FI SET MONUMENTS BY TERAN GROUP
SET MONUMENTS BY TERAN GROUP	FI FIRE HYDRANT
GAS LINE MARKER	BOLLARD BOLLARD
SPRINKLER HEAD	OP.R.R.P.H.C. OFFICIAL PUBLIC RECORDS OF REAL PROPERTY PER HARRIS COUNTY

AS-BUILT SURVEY OF
UNRESTRICTED RESERVE "A"
ALMEDA PLACE DEVELOPMENT,
FILM CODE 697617, H.C.D.R.,
SITUATED IN THE P.W. ROSE SURVEY,
ABSTRACT NO. 645, HARRIS COUNTY, TEXAS

DRAWN BY: TERAN GROUP	07-16-2026	TERAN GROUP PROJECT NO. 2022-052
APPROVED BY: OJT	07-16-2026	
SCALE: 1"=20'		SHEET NO 1 OF 1

