
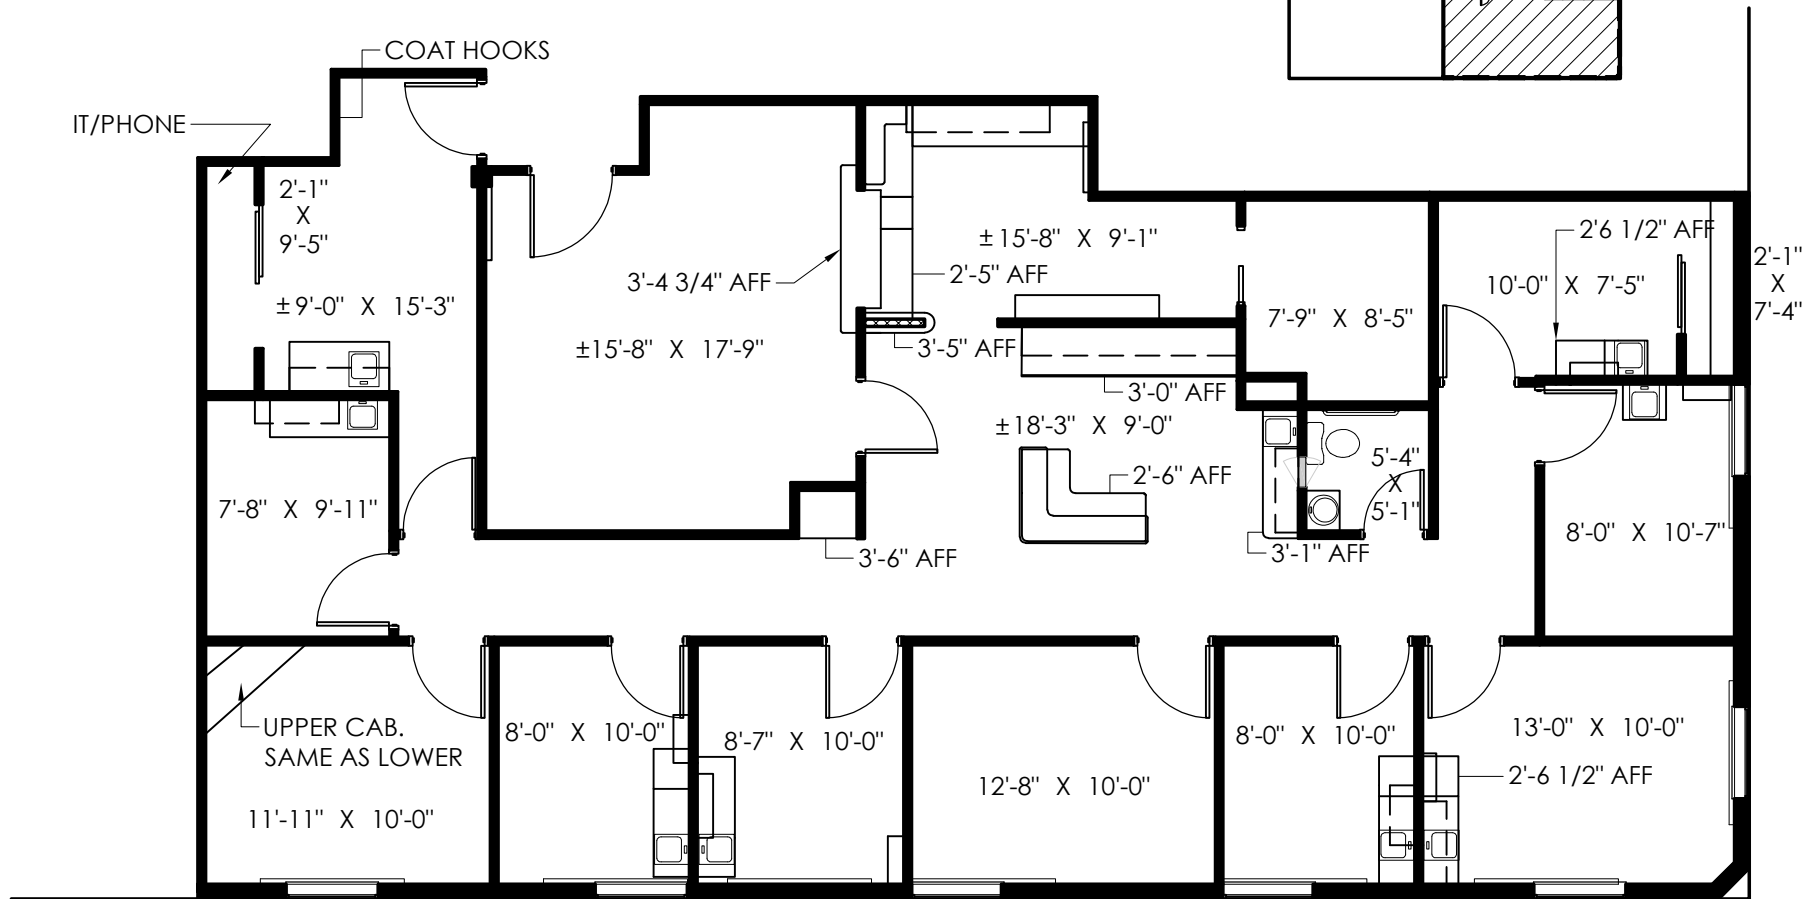


9301 Golf Road

Des Plaines, Illinois 60016

Key Plan:

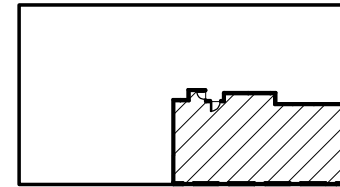

Suite #205 - As-Built Conditions

2,331 Rentable Square Feet

Scale:

1/8" = 1'-0"



North