


Proximity Plan

1 As Built Floor Plan
Suite 110

2,470 RSF (Approx.)

Not to Scale

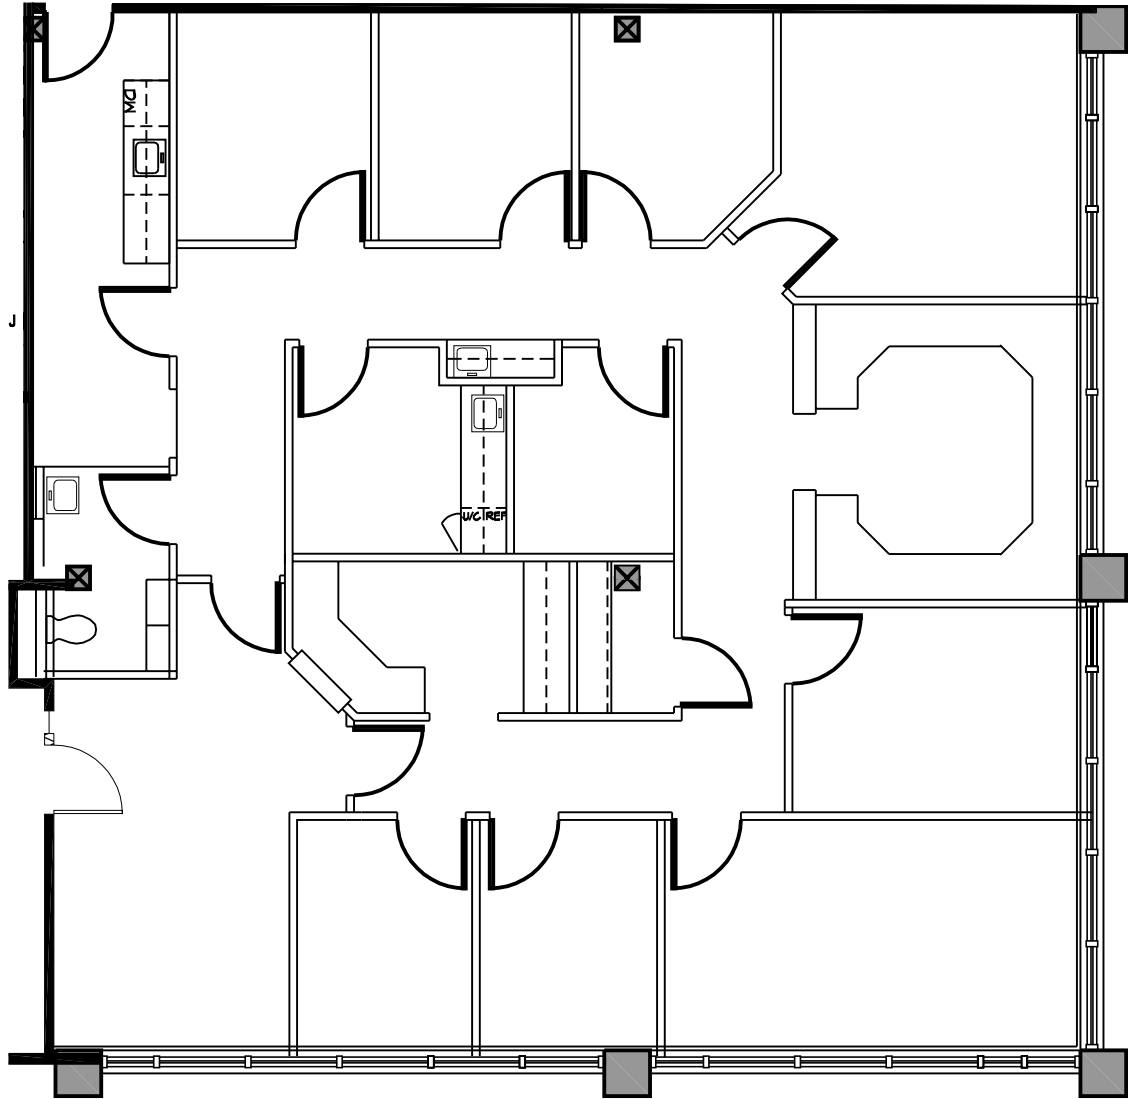

1st Floor As-Built

274 Union

TPS
TENANT
PLANNING
SERVICES
INCORPORATED
1660 Lincoln St, Ste. 100
Denver, Colorado 80264
(303) 861-4800
fax (303) 861-1621
www.TPS.design

As Built Floor Plan
Issued: 2 March 2022
Drawn by: ES / FAO / FAO
TPS Project #: 475001

274 Union
Level First; Suite 110
274 Union Blvd
Lakewood, CO 80228