

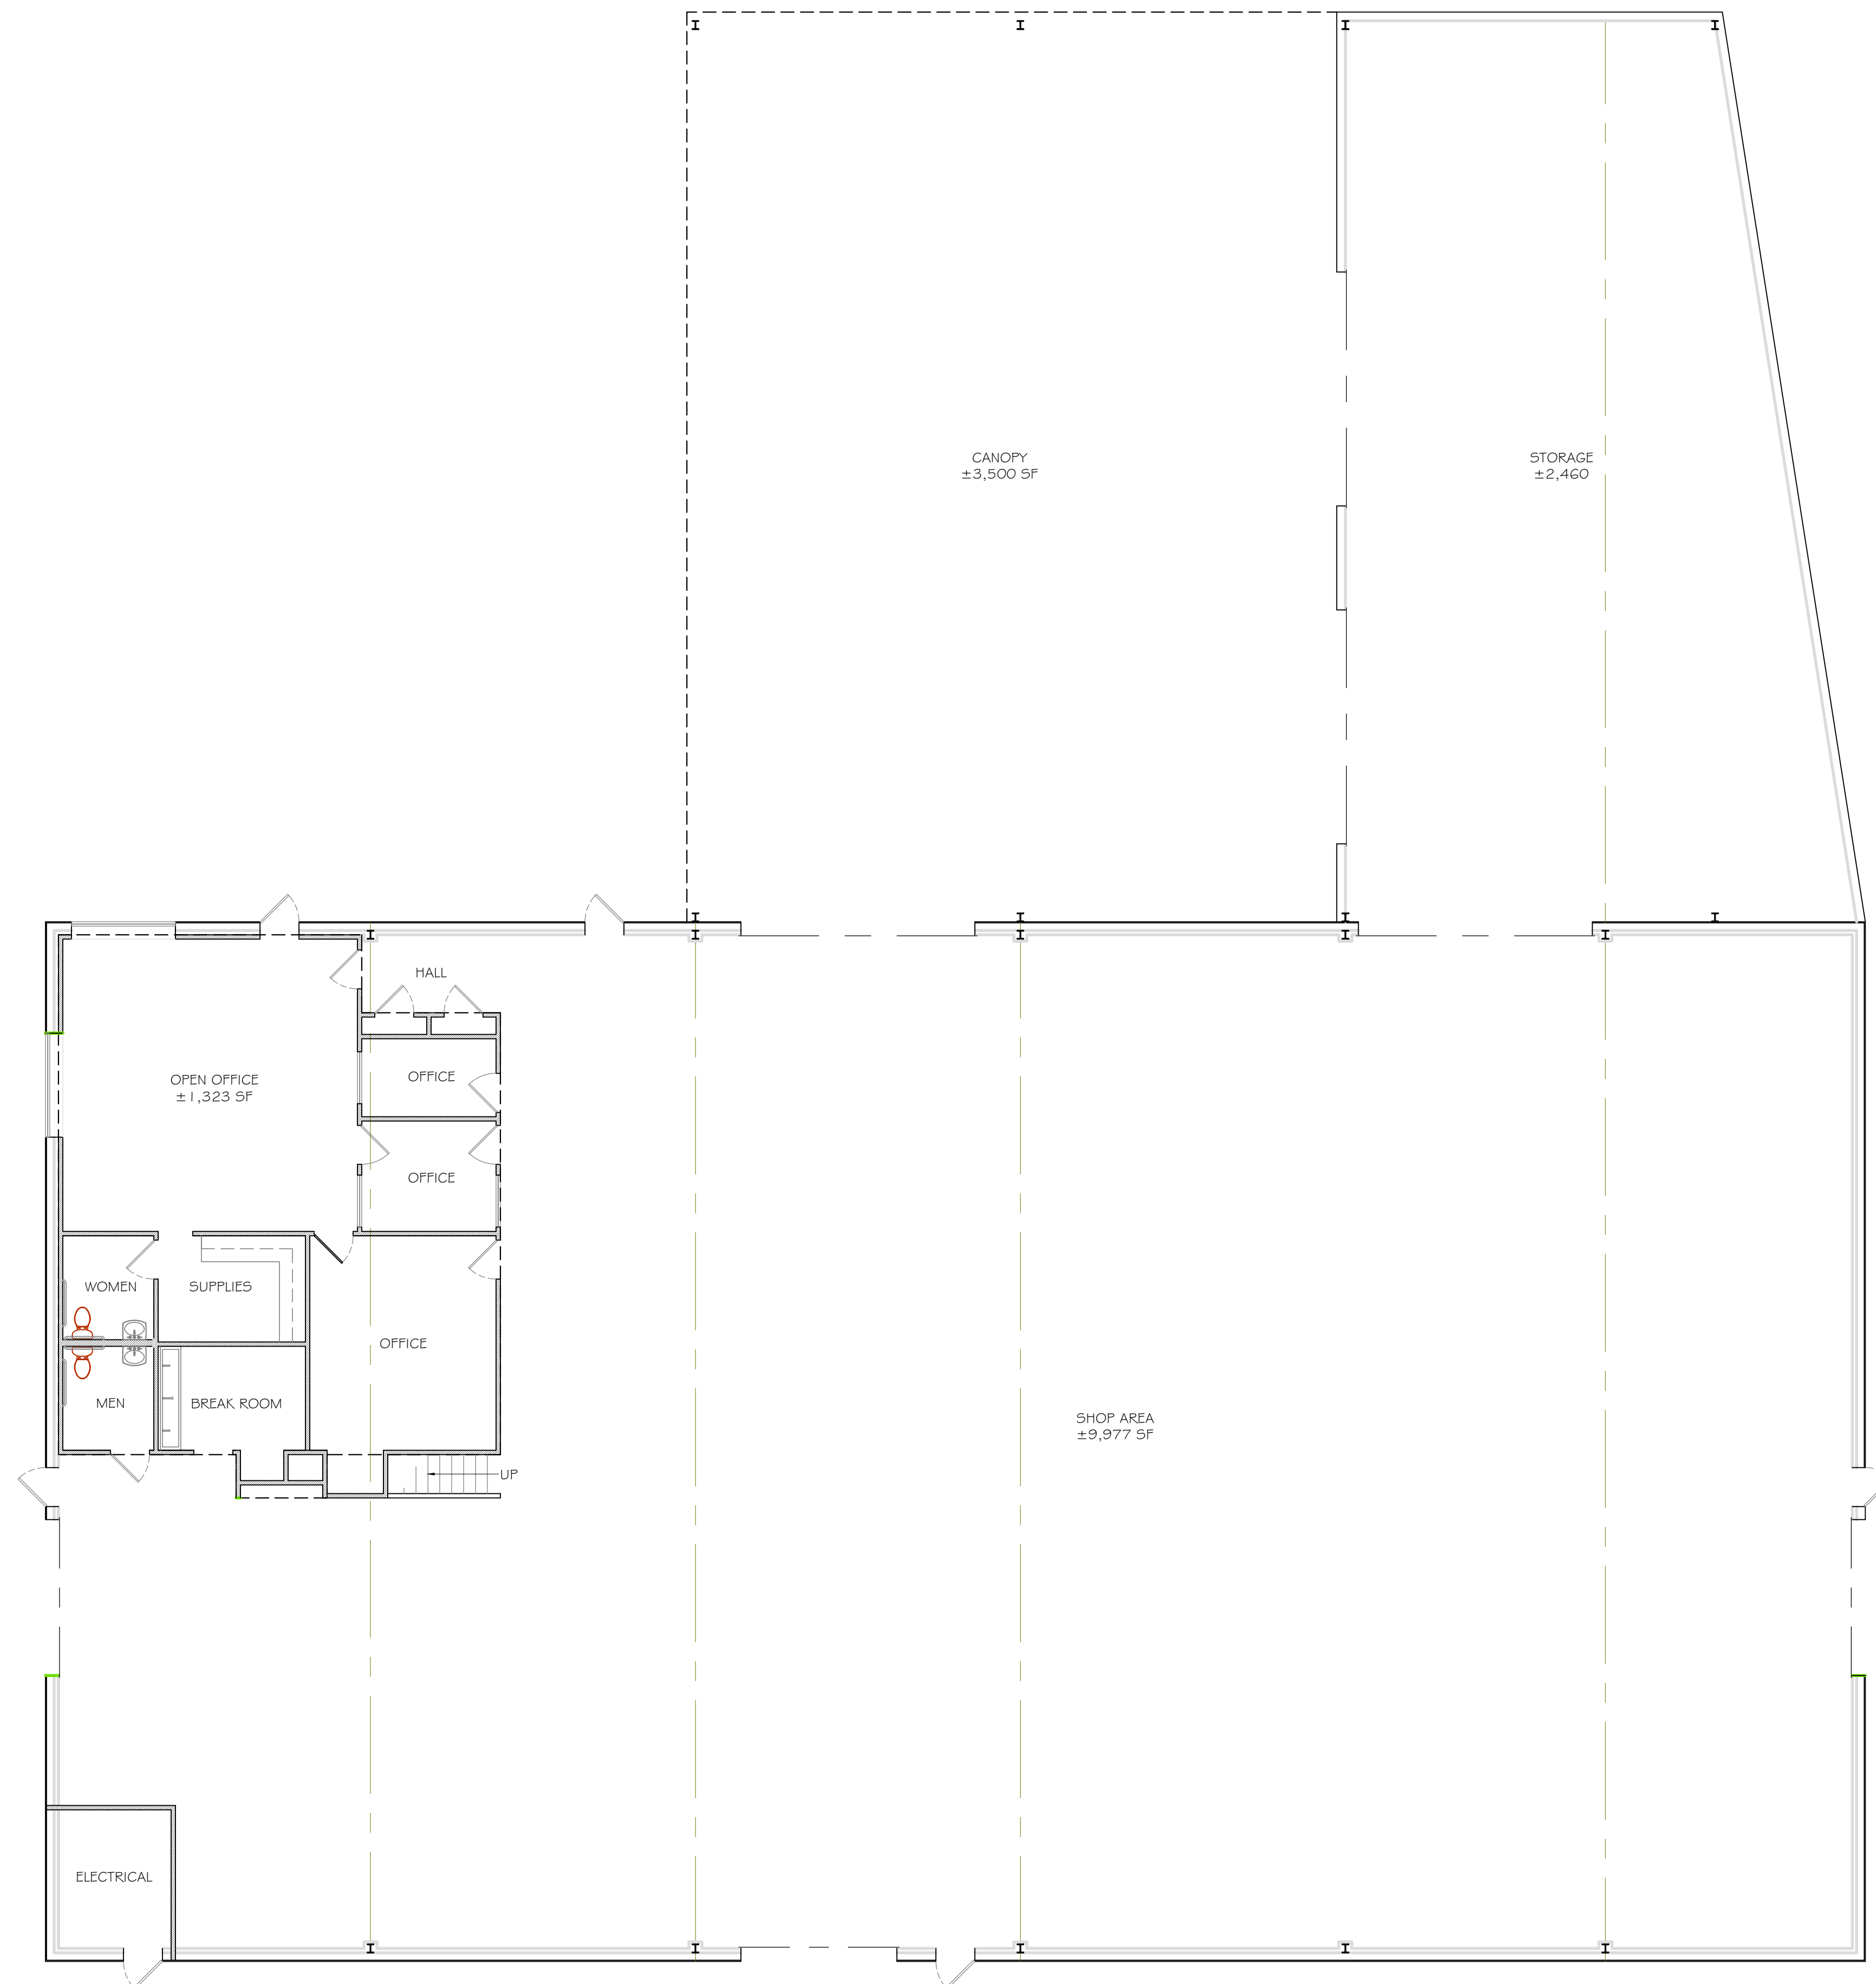


AS-BUILT MEZZANINE
SCALE: 1/8" = 1'-0"

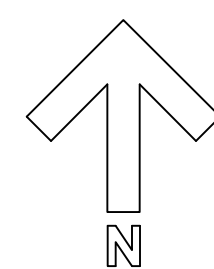

AS-BUILT FLOOR PLAN - 13,660 EXISTING BUILDING
SCALE: 1/8" = 1'-0"

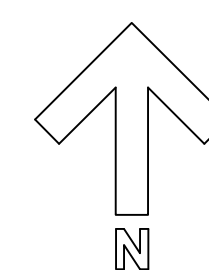

TO VERIFY SCALES 0" 1" BAR SHOULD MEASURE ONE INCH BY ONE SIXTEENTH INCH

AS-BUILT

ASPECT DESIGN, LLC
CHERYL LARGE

CELL: 541-601-4172
EMAIL: aspectdesignllc@yahoo.com

PROJECT DESCRIPTION:
As-Built Industrial Building

PROJECT LOCATION:
227 Kearney Street Extension
Watsonville, CA 95076
ACCESSOR'S PARCEL NUMBER:
18-211-21

Approved for the Owner By: _____ Date: _____

REVISIONS	BY

PLOT DATE: 06-02-26

ISSUE DATE:

DRAWN BY: CLL

JOB NO.:

SHEET

A1.1
FLOOR PLAN