


Property Key

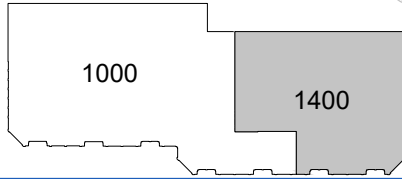

WMGSA Roosevelt As Built Marketing Package

10901-11001 Roosevelt Boulevard and 1000 112th Circle, St. Petersburg, FL 33716

Building: 3
Suite: 3-1400
Sheet: A-2


Scale: Not to Scale
Sheet Size: 8.5" x 11"
Not For Construction



Total Area - 24,678 SF

Building Information

DECK HEIGHT:	N/A
CEILING HEIGHT:	9'-0"
CLEAR HEIGHT:	14'-10"
SPRINKLERED:	Yes

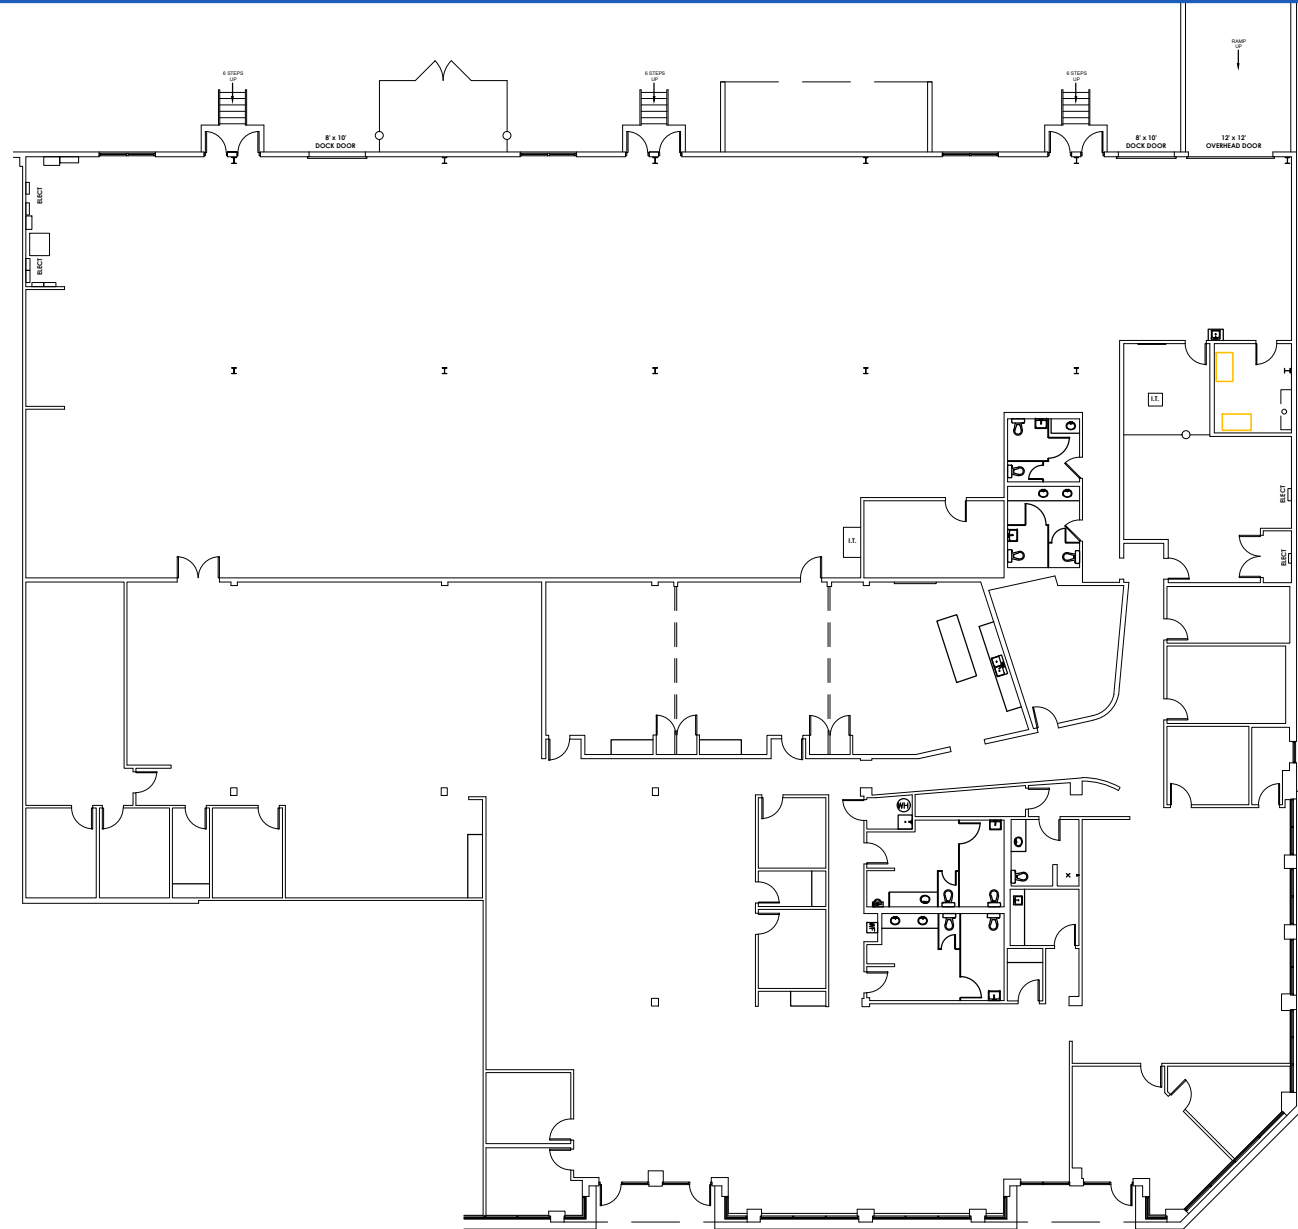

As Built Floor Plan for Marketing

