


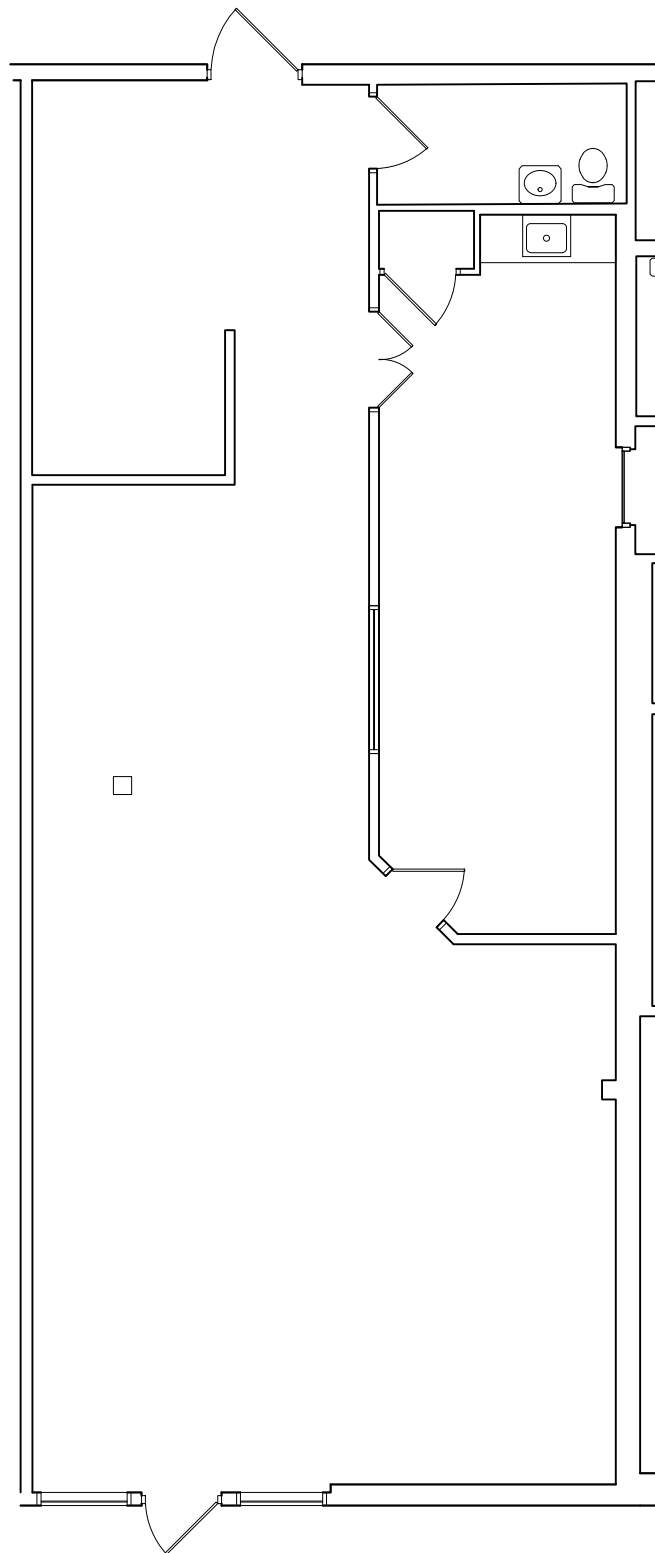

1506 RSF
A FLOOR PLAN
SCALE: 1/8"=1'-0"  NORTH




KKT ARCHITECTS, INC.
2200 SOUTH UTICA PLACE, SUITE 200
TULSA, OKLAHOMA 74114
[P] 918.744.4270 \ [F] 918.744.7849
WWW.KKTARCHITECTS.COM
C O F A # 5 3 4 6 / 3 0 / 2 7

SUITE 931

BOARDWALK
SHOPPING CENTER
931 N ELM PL
BROKEN ARROW, OK

HOUSTON
REAL ESTATE
GROUP, INC.

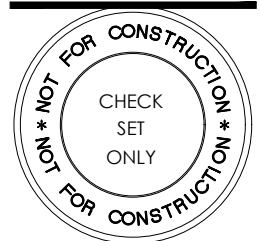

09/03/2025

CJ

AS-BUILT
PLAN

AS.1