


ONE LAKESIDE COMMONS

SUITE 1000

22,999 RSF

AS-BUILT PLAN

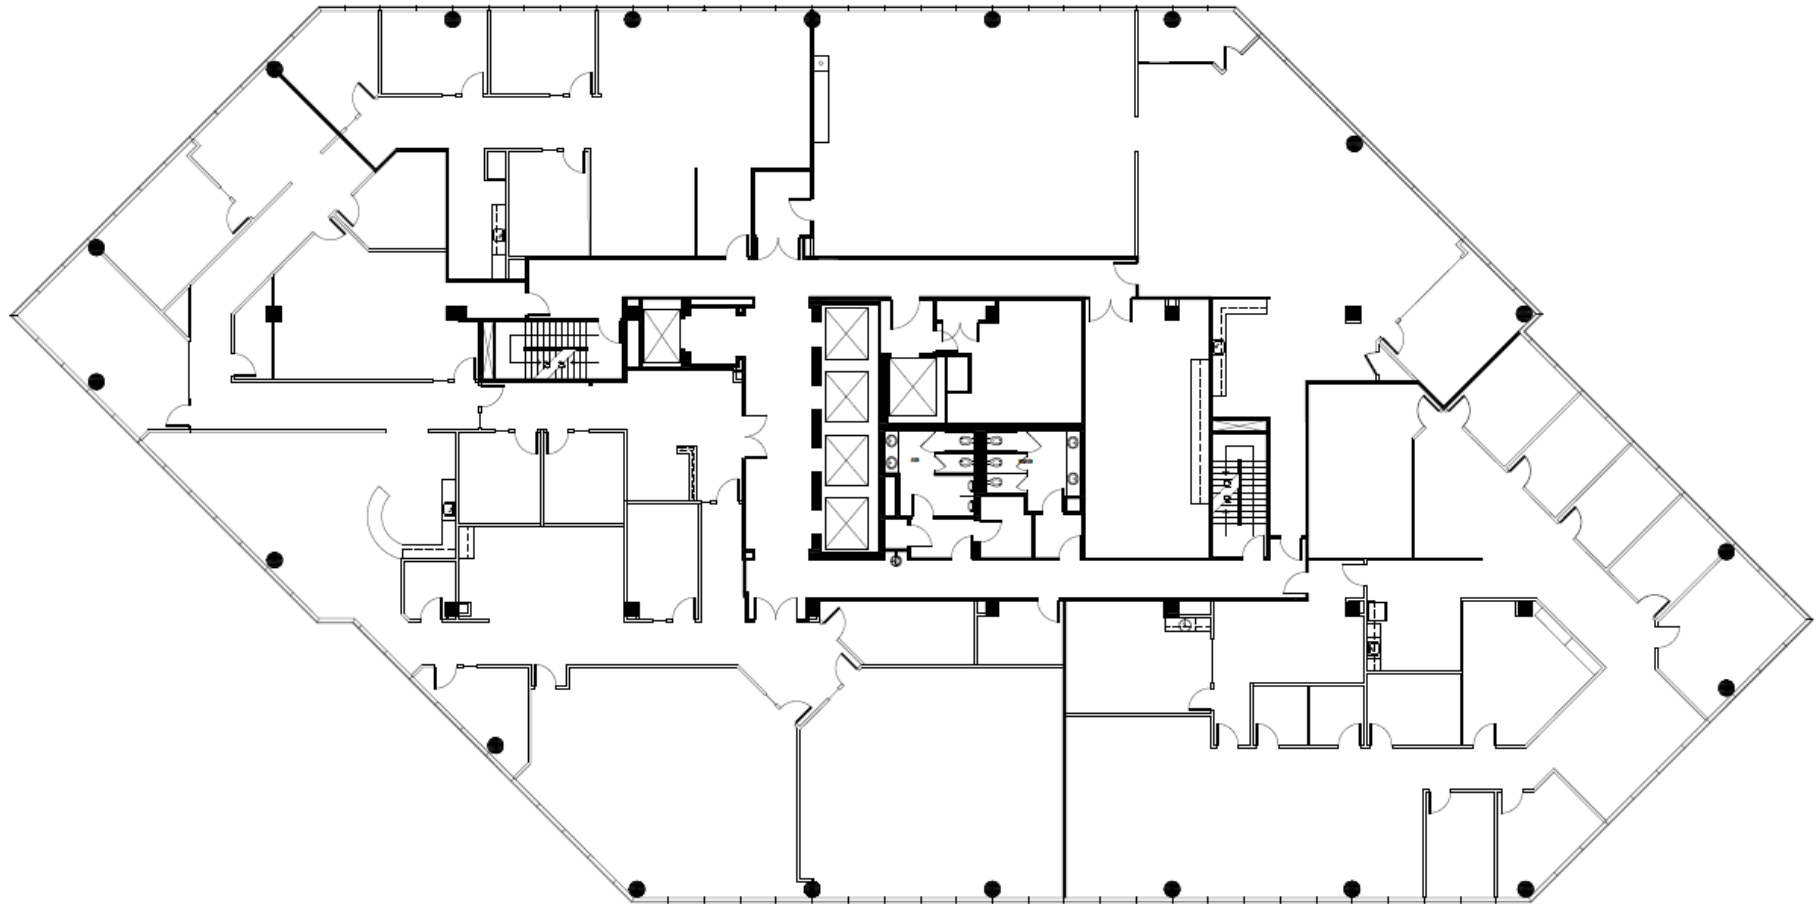

INTERCONTINENTAL
REAL ESTATE CORPORATION

NEWMARK

One Lakeside Commons, 990 Hammond Drive, Atlanta, GA 30328

Tom Miller, Executive Managing Director | tom.miller@nmrk.com | 770.552.2411