
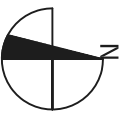


# 1100 Arizona State Route 260

Cottonwood - Arizona  
Suite C2 - 1,418 SF

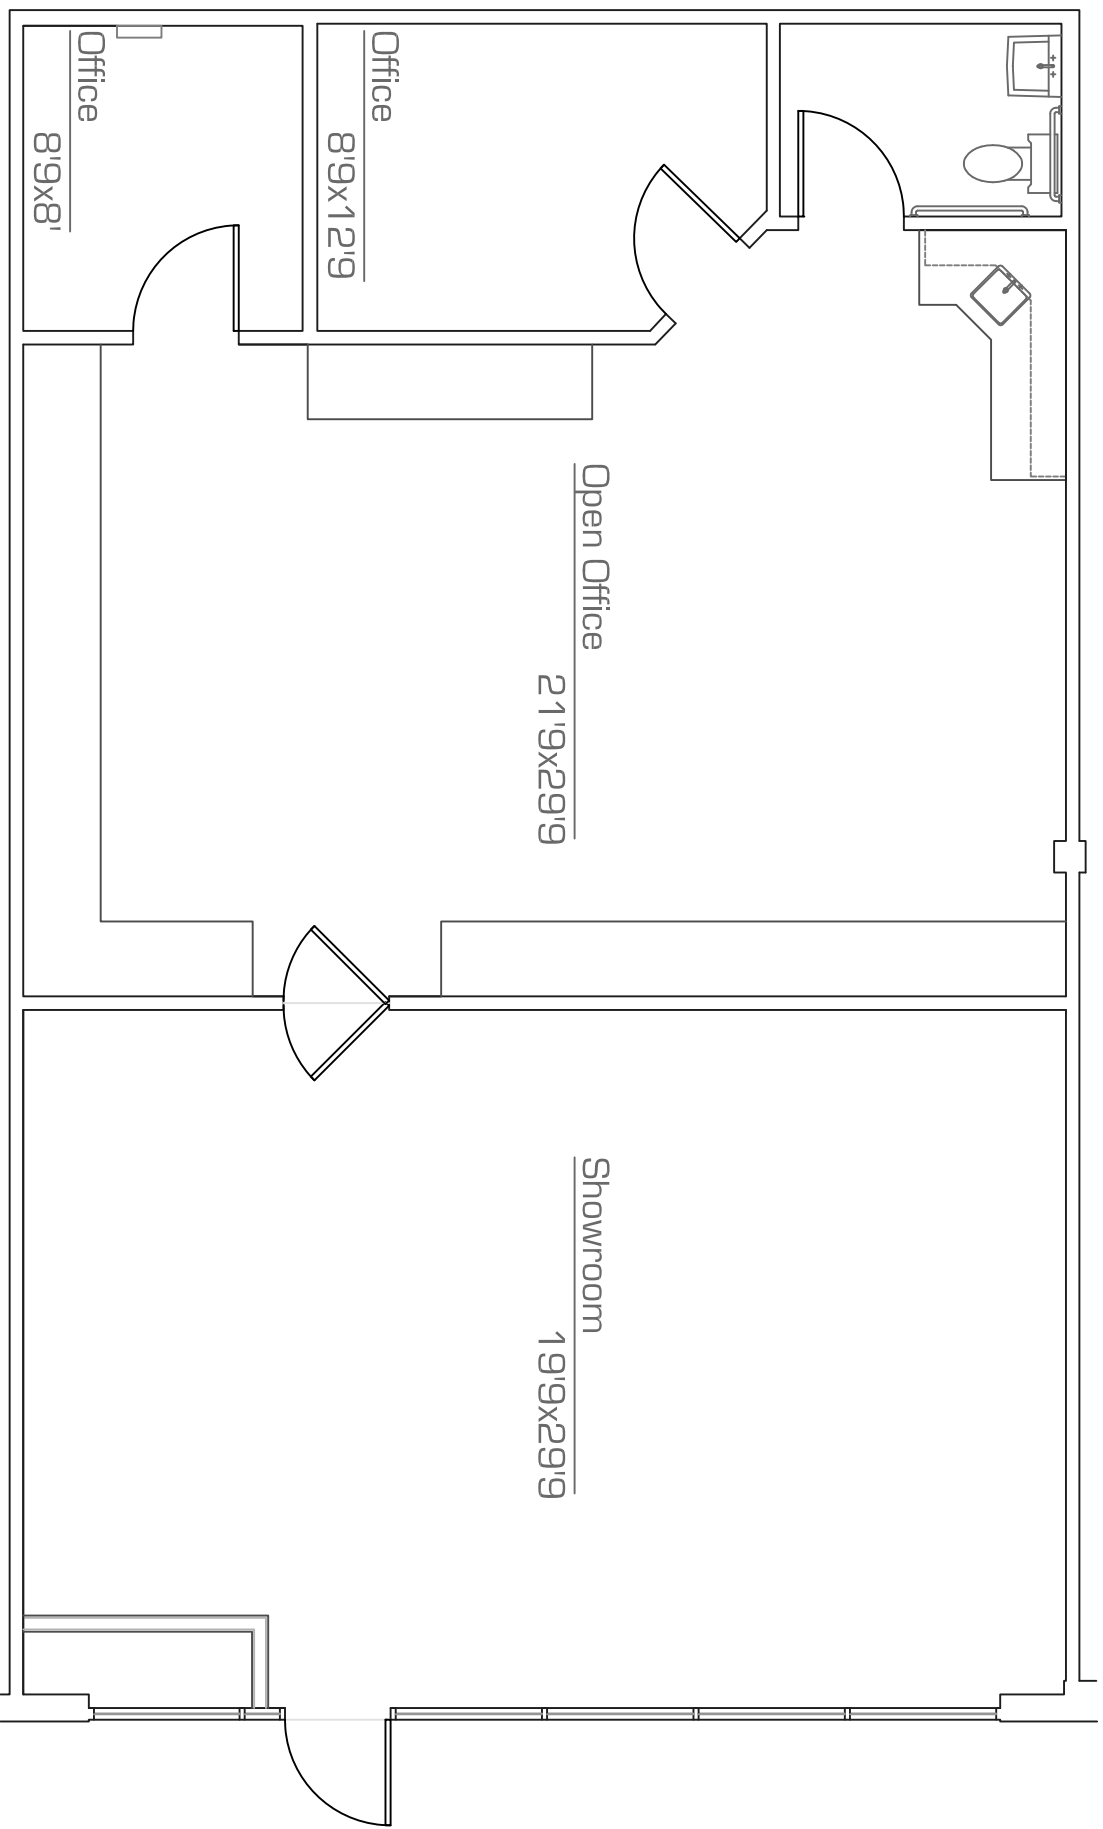

**as-built**

scale: nts  
November . 2010

\* All dimensions are approximate  
\* All information is of general nature

precision **DIMENSIONS**



as built . space plans  
architectural design  
602.790.6412