

WEBB
MEDICAL
PLAZA B


Floor 03

Suite 301

AS-BUILT

7,554 SF

AVAILABLE

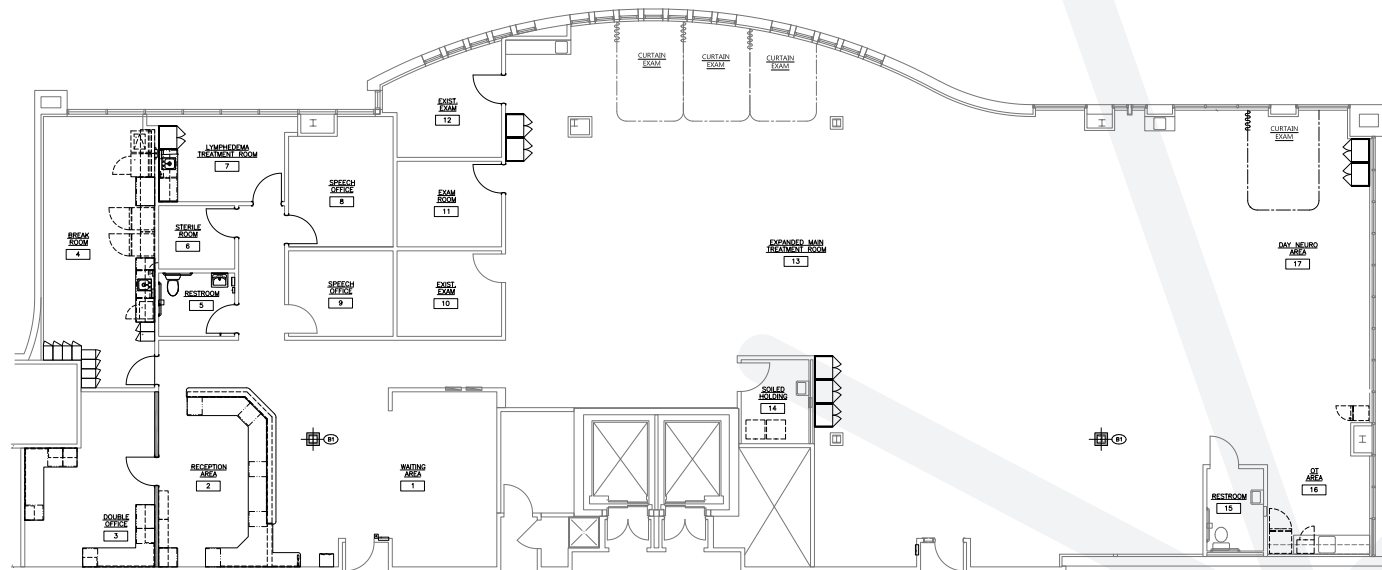

RACHAEL THOMPSON
Senior Vice President
602.513.5122
rachael.thompson@kidder.com

PERRY GABUZZI, CCIM
Senior Vice President
602.513.5116
perry.gabuzzi@kidder.com