


## Suite A-201-205 | 3,798 SF

AS BUILT FLOOR PLAN

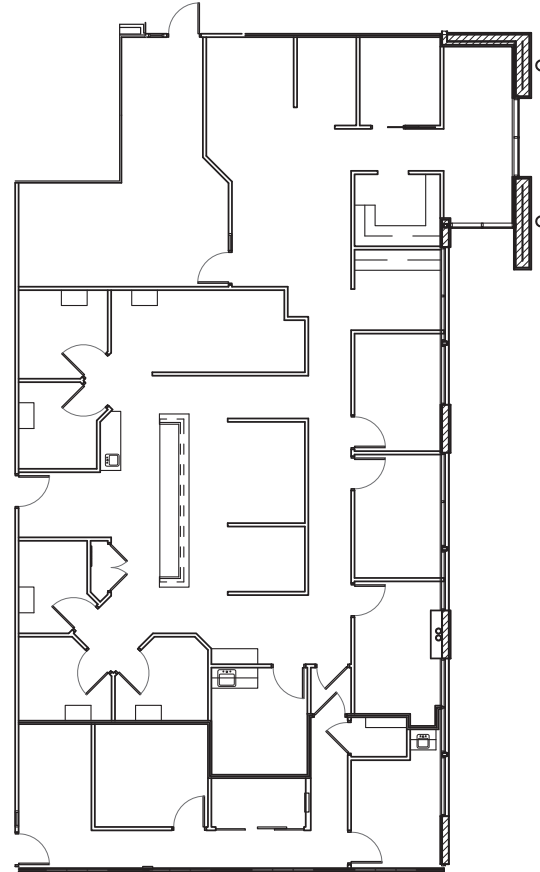

OWNED BY



LEASING BY

**Rachael Thompson**  
602.513.5122  
rachael.thompson@kidder.com

**Perry Gabuzzi, CCIM**  
602.513.5116  
perry.gabuzzi@kidder.com

